

MISSISSIPPI DEPARTMENT OF ENVIRONMENTAL QUALITY

Office of Land and Water Resources

COUNTY WELL LOCATED
Sunflower

WELL NUMBER
G-105

CODED

PERMIT NUMBER

DATE WELL COMPLETED
3-25-01

NAME OF DRILLING FIRM
Irrigation Equipment Inc.

Indianola, MS

P. O. Box 10631
Jackson, MS 39289-0631
WATER WELL DRILLERS LOG

NAME & MAILING ADDRESS OF LANDOWNER
Winding Brook Corp.

Box 98
Inverness, MS 38753

Latitude:
Longitude:

WELL LOCATION: SEC TOWNSHIP RANGE
ne/nw 9 21N: N 4W E
S W

DISTANCE DIRECTION NEAREST TOWN
6 Miles NW Doddsville

OTHER LANDMARK

WELL PURPOSE: Home, Irrigation, Municipal, Industrial, Fish Pond, etc.
Irrigatio

PUMP DATA

PUMP TYPE (Circle One):
Submersible, **Turbine** Jet Flowing Well,
Other (Describe)

POWER TYPE (Circle One):
Electric, Tractor, **Diesel**, Gasoline, Butane,
Other (Describe) **H/P 40**

DESCRIPTION OF FORMATIONS ENCOUNTERED	FROM	TO
Clay	0	15
Brown Sand	15	35
Fine Sand	35	85
Clay	85	105
Fine Sand	105	115
Clay	115	125
Fine sand	125	135
Coarse Sand/gravel	135	150

WELL DATA

Well Depth 150	Casing Diameter (In.) 16	Casing Length (Ft.) 130
Type of Casing pvc	Hole Depth 150	Depth to Static Water Level 49ft.
TYPE OF COMPLETION: (Circle One or More): Gravel Packed , Underreamed, Telescoped, Natural Development, Open Hole, Other (Describe)		
WELL GROUTED TO A DEPTH OF _____ FEET Type Grout (circle one): Cement, Bentonite, or Mix		

SCREEN DATA

Diameter - Inches 16	Length - Feet 20ft.	Slot Size - Inches .050
Screen Type pvc	Depth to Bottom - Feet 150	

RECEIVED

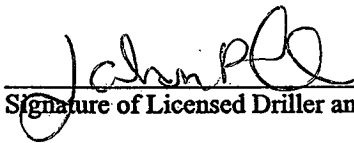
AUG 15 2001

Dept. of Environmental Quality
Office of Land & Water Resources

Top of Lap Pipe or Reduction in Casing

FEET IF TELESCOPED OR MORE THAN ONE SCREEN: USE BACK PAGE

I certify that the well was drilled, constructed and completed in accordance with all applicable Requirements of the Mississippi Department of Environmental Quality and/or the Mississippi Department of Health regulations and state laws.


Signature of Licensed Driller and License No.

0-439 8-13-01
Date

Additional Information Required On Back

If well telescopes please sketch and show depths.

GROUND LEVEL

	X		

SECTION 9

Please indicate well location X.

Pump Capacity (GPM)	No. of Stages	Setting Depth
2000	2	70 FT.

PUMP TEST

Well yielded _____ GPM with
 a drawdown of _____ ft.
 after _____ hours of pumping

LOG DATA

TYPE OF LOG RUN (Circle One): No Log Run,
 Electric, Gamma Ray, Density, Sonic, Neutron,
 Other (Describe) _____

Name of Organization Running Log

GEOLOGIC DATA (Office Use Only)

Surface Elev.	Geologic Unit	Unit Thickness	Depth to Top
Subs. SWL	Date	Analysis	Aquifer Test

Driller's Remarks

If more than one screen,
 show location of each on sketch.