

MISSISSIPPI DEPARTMENT OF ENVIRONMENTAL QUALITY

Office of Land and Water Resources

P. O. Box 10631

Jackson, MS 39289-0631

WATER WELL DRILLERS LOG

COUNTY WELL LOCATED Sunflower	
WELL NUMBER G-107	CODED
DATE WELL COMPLETED 5-20-02	

PERMIT NUMBER
NAME OF DRILLING FIRM Irrigation Equipment Inc.
Indianola, MS

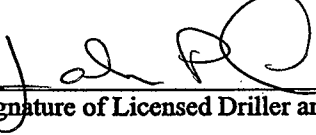
NAME & MAILING ADDRESS OF LANDOWNER W.H. Myers Estate Box 530092 Birmingham, AL 35253			
Latitude: Longitude:			
WELL LOCATION SE/NE	SEC 19	TOWNSHIP 21N	RANGE N 4W
DISTANCE West		DIRECTION Doddsville	
OTHER LANDMARK			
WELL PURPOSE: Home, Irrigation, Municipal, Industrial, Fish Pond, etc. Irrigation			

PUMP DATA		
PUMP TYPE (Circle One): Submersible, <u>Turbine</u> , Jet, Flowing Well, Other (Describe)		
POWER TYPE (Circle One): Electric, Tractor, <u>Diesel</u> , Gasoline, Butane, Other (Describe) H/P 60		
DESCRIPTION OF FORMATIONS ENCOUNTERED	FROM	TO
Clay	0	28
Fine Sand	28	35
Fine Sand/gravel	35	41
Med. Sand/gravel	41	115
RECEIVED		
AUG 26 2002		
BY: OLWR		
Top of Lap Pipe or Reduction in Casing		
FEET	IF TELESCOPED OR MORE THAN ONE SCREEN: USE BACK PAGE	

WELL DATA		
Well Depth 115	Casing Diameter (In.) 16	Casing Length (Ft.) 75
Type of Casing pvc	Hole Depth 115	Depth to Static Water Level 45ft.
TYPE OF COMPLETION: (Circle One or More): <u>Gravel Packed</u> , Underreamed, Telescoped, Natural Development, Open Hole, Other (Describe)		
WELL GROUTED TO A DEPTH OF _____ FEET Type Grout (circle one): Cement, Bentonite, or Mix		

SCREEN DATA		
Diameter - Inches 16	Length - Feet 40	Slot Size - Inches .050
Screen Type pvc	Depth to Bottom - Feet 115	

I certify that the well was drilled, constructed and completed in accordance with all applicable Requirements of the Mississippi Department of Environmental Quality and/or the Mississippi Department of Health regulations and state laws.

 0439 8-22-02
Signature of Licensed Driller and License No. Date

If well telescopes please sketch and show depths.

GROUND LEVEL

			X

SECTION 19

Please indicate well location X.

Pump Capacity (GPM) 2500 to 3000	No. of Stages 1	Setting Depth 70 FT.
--	--------------------	-------------------------

PUMP TEST

Well yielded _____ GPM with
a drawdown of _____ ft.
after _____ hours of pumping

LOG DATA

TYPE OF LOG RUN (Circle One): _____ No Log Run.
Electric, Gamma Ray, Density, Sonic, Neutron,
Other (Describe) _____

Name of Organization Running Log

GEOLOGIC DATA (Office Use Only)

Surface Elev.	Geologic Unit	Unit Thickness	Depth to Top
Subs. SWL	Date	Analysis	Aquifer Test

Driller's Remarks

If more than one screen,
show location of each on sketch.