

MISSISSIPPI DEPARTMENT OF ENVIRONMENTAL QUALITY

Office of Land and Water Resources

P. O. Box 10631
Jackson, MS 39289-0631
WATER WELL DRILLERS LOG

COUNTY WELL LOCATED
Sunflower

WELL NUMBER
3-110

CODED

DATE WELL COMPLETED
6-21-03

PERMIT NUMBER

NAME OF DRILLING FIRM
Irrigation Equipment Inc.

Indianola, MS

NAME & MAILING ADDRESS OF LANDOWNER
W.H. Myers Estate

Box 530092
Birmingham, AL 35253

Latitude:

Longitude:

WELL LOCATION. SEC TOWNSHIP RANGE

SE/NW 19 21N N S 4W W

DISTANCE DIRECTION NEAREST TOWN

Miles **West** of **Doddsville**

OTHER LANDMARK

WELL PURPOSE: Home, Irrigation, Municipal, Industrial, Fish Pond, etc.
Irrigation

WELL DATA

Well Depth 125	Casing Diameter (In.) 12	Casing Length (Ft.) 85
Type of Casing pvc	Hole Depth 125	Depth to Static Water Level 45ft.

TYPE OF COMPLETION: (Circle One or More):
 Gravel Packed Underreamed, Telescoped,
 Natural Development, Open Hole, Other
(Describe)

WELL GROUTED TO A DEPTH OF **10** FEET
Type Grout (circle one): **Cement**, Bentonite, or Mix

SCREEN DATA

Diameter - Inches 12	Length - Feet 40	Slot Size - Inches .050
Screen Type pvc		Depth to Bottom - Feet 125

PUMP DATA

PUMP TYPE (Circle One):
 Submersible, Turbine, Jet Flowing Well,
Other (Describe)

POWER TYPE (Circle One):
 Electric, Tractor, Diesel, Gasoline, **15** Butane,
Other (Describe) _____ H/P _____

DESCRIPTION OF FORMATIONS ENCOUNTERED	FROM	TO
Clay	0	28
Fine Sand	29	35
Fine Sand/gravel	36	50
Med. Sand/gravel	51	125

RECEIVED

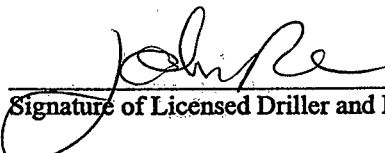
JUL 07 2003

BY: OLWR

Top of Lap Pipe or Reduction in Casing

FEET IF TELESCOPED OR MORE THAN ONE SCREEN: USE BACK PAGE

I certify that the well was drilled, constructed and completed in accordance with all applicable Requirements of the Mississippi Department of Environmental Quality and/or the Mississippi Department of Health regulations and state laws.

 **0439**
Signature of Licensed Driller and License No.

7-2-03
Date

Additional Information Required On Back

If well telescopes please sketch and show depths.

GROUND LEVEL

	X		

SECTION 19

Please indicate well location X.

Pump Capacity (GPM)	No. of Stages	Setting Depth
750	1	70 FT.

PUMP TEST

Well yielded _____ GPM with
a drawdown of _____ ft.
after _____ hours of pumping

LOG DATA

TYPE OF LOG RUN (Circle One): No Log Run,
 Electric, Gamma Ray, Density, Sonic, Neutron,
Other (Describe) _____

Name of Organization Running Log _____

GEOLOGIC DATA (Office Use Only)

Surface Elev.	Geologic Unit	Unit Thickness	Depth to Top
Subs. SWL	Date	Analysis	Aquifer Test

Driller's Remarks

If more than one screen,
show location of each on sketch.