	State W	ell Report	For Office Use Only:	
County: Sunflower	Part 1			
Permit # $6\omega4/595$ Mis	Mississippi Department of Environmental Quality		Aquifer:	
Irrigation Equipment		nd Water Resources lox 10631	Well #: 6-132	
Driller:		IS 39289-0631	L. S. Elevation:	
Date drilling completed:		961-5210		
	(601)354	1-6938 (fax)	E-log #:	
State Law requires that this report b 30 days of completion of drilling of the		driller in detail and filed w	ith the Department within	
Well Owner Information		Well	Location	
Owner Name Eastland Plan	tation	Latitude: 33 , 38 ,54.	Longitude: ,03.,7 Longitude: ,03.,7 (a): Conventional Survey,	
Mailing Address: Box 25		Method of Lat/Long (circle or	e): Conventional Survey,	
			GPS, Survey-grade GPS	
Doddsville 1		,	Twn 21N Rng 4W	
City State	Zip Code	Distance Direction 4 Miles West	Nearest Town of Doddsville	
662-756-4616 Telephone No. (Miles Webe	or <u>Doddovillo</u>	
	Well I	Jata	İ	
Purpose of Well (circle one) Home Industria	l Public Supply	Irrigation Fish Culture	Other:	
Date well drilling started: 3-8-07	Date v	vell drilling completed:	3-8-07	
If flowing, method of flow regulation: Valve _	Other (d	escribe)		
Static Water Level: 49 feet above of	orbelow (circle one) l	and surface Date measured:	3-9-07	
Method of Measurement (circle one) teel ta	pe electric tape	air line other:		
Hole depth: 124 Well depth: 124 Well grouted to a depth of 10 feet				
Type of grout (circle one): Cement	entonite Mix			
Casing length: 84 feet Casing dia	meter: 16	_inches Type of casing:	1	
Screen length: 40 feet Screen die	16	inches Type of screen:	PVC Sch.40	
Screen slot size: 050 inches Screen	etting depth: From _	85 feet to 12	2.4 feet	
Type of completion (circle all applicable): G	evel packed Under	reamed Telescoped Open	hole Natural Development	
Other (describe):				
Top of lap pipe or reduction in casing: feet. If telescoped or more than one screen, describe on back of page				
Logs run (circle all applicable): No log run Electric Gamma Ray Density Sonic Neutron Other:				
Name of organization running log(s): I certify that the well was drilled, constructed, and completed in accordance with all applicable requirements of the Mississippi				
Department of Environmental Quality and/or the Mississinni Department of Health regulations and state laws				

Irrigation Equipment Inc. Patrick M. Chism 0695

Print Name of Water Well Contractor and License No.

RECEIVED

Signature of Water Well Contractor


MAR 3 0 2007

Ground Level

Description of Formations Encountered	d From To
Clav	0 23
Fine Sand Fine Sand/gravel Med. Sand/gravel	24 35
Fine Sand/gravel	36 50
Med. Sand/gravel	51 1 24
<u> </u>	

If more than one screen, show location of each on sketch

Sketch the property layout and include the following: 1) the well location; 2) any permanent structures on the property that may aid in locating the well; 3) any roads, power lines, or other items that may aid in locating the property and the well; 4) indicate direction.

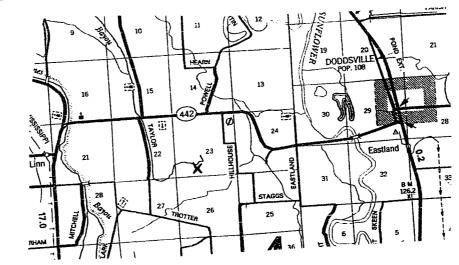

Landowner Name:

Signature of Water Well Contractor

STATE WELL REPORT

Part 2

Sunflower Pump Installer's Completion Report
Mississippi Department of Environmental Quality
Office of Land and Water Resources Irrigation Equipment

County: Permit#:

Date completed: $_{-3}$ - 8 - 0 7

P.O. Box 10631 Jackson, MS 39289-0631 (601)961-5210 (601)354-6938 (fax)

For Office Use Only:			
Aquifer:			
Well #: _	G-	132	
Elevation	·		

installation		by the pump installer in det	ail and filed with th	ie Department within 30 da	ays of the
Well Owner Information		Well Location			
Owner Name:	Eastland Plantation		Latitude:	Longitude:	
Mailing Address: Box 25		Method of Lat/Long (circle one): Conventional Survey,			
	~	f	USGS	quad, Hand-held GPS, Sur	rvey-grade GPS
	Doddsville City St	MS 38736	SE 1/SW	4 Sec 23 Twn 211	N Rng 4W
Talendaria No. (662-756-4	•	Distance	Direction Nearest To	
Telephone No. (4 Miles	West of Dodds	VIIIE
Pump Type Circle one		Power Type Circle one			
Air Lift	Jet	Submersible	Diesel Engine	Gasoline Engine	Natural Gas

	Pump Type Circle one			Power Type Circle one	
Air Lift	Jet	Submersible	Diesel Engine	Gasoline Engine	Natural Gas
Bucket	Piston	Indian	Electric Motor	Hand	Tractor PTO
Centrifugal	Rotary	Flowing Well	Windmill	Other (specify):	
Other (specify):			Horse Power Rating	of Motor: 60	·
Date Pump Installed:	3-9	9-07	Setting Depth:	70	_feet
Rated Pump Capacity: _	2800±	Gallons Per Minute	Number of Stages: _	1	

Punap Test Data	Method of Measuring Water Level Circle one		
Date Well Tested:	Cardie one		
Static Water Level (A):Feet Below Land Surface	Air Line Electric Measuring Line Steel Tape		
Pumping Water Level (B):Feet Below Land Surface	Other (specify):		
Drawdown [(B) - (A)]:Feet Below Land Surface	For flowing well, measured shut in head:feet		
Test Pumping Rate: Gallons Per Minute	Well yieldedGPM with a drawdown of		
Duration of Pump Test (minimum 4 hours):hours	feet afterhours of pumping		

I HEREBY CERTIFY that the above statements are true to the best of repairing Patrick M. Chism 0695 Print Name of Pump Installer and License No. (if applicable)	h khowikdge Votal M Q Signature of Pump Installer	RECEIVED
	····	