

State Well Report

Part I

Mississippi Department of Environmental Quality
Office of Land and Water Resources
P.O. Box 10631
Jackson, MS 39289-0631
(601)961-5210
(601)354-6938 (fax)

For Office Use Only:

Aquifer:
Well #: G-133
L. S. Elevation:
E-log #:

County: Sunflower
Permit #: GW 41908
Irrigation Equipment
Driller:
Date drilling completed: 6-29-07

State Law requires that this report be prepared by the driller in detail and filed with the Department within 30 days of completion of drilling of the well.

Well Owner Information: Owner Name G and G Farms, Mailing Address 918 Hwy 442, Shaw Ms. 38773, Telephone No. 662-207-0050. Well Location: Latitude 33° 38' 56.8", Longitude 90° 35' 18.4", Method of Lat/Long Conventional Survey, USGS quad, Hand-held GPS, Survey-grade GPS, Distance 4 Miles, Direction W, Nearest Town Doddsville.

Well Data: Purpose of Well Irrigation, Date well drilling started 6-29-07, Date well drilling completed 6-29-07, Static Water Level 54 feet above or below land surface, Method of Measurement steel tape, Hole depth 126, Well depth 126, Well grouted to a depth of 10 feet, Type of grout Bentonite, Casing length 86 feet, Casing diameter 10 inches, Type of casing PVC, Screen length 40 feet, Screen diameter 10 inches, Type of screen PVC, Screen slot size .050 inches, Setting depth From 87 feet to 126 feet, Type of completion Gravel packed, Top of lap pipe or reduction in casing, Logs run No log run.

Name of organization running log(s):

I certify that the well was drilled, constructed, and completed in accordance with all applicable requirements of the Mississippi Department of Environmental Quality and/or the Mississippi Department of Health regulations and state laws.

Irrigation Equipment Inc.
Patrick M. Chism 0695

Signature of Water Well Contractor (Handwritten Signature)

Print Name of Water Well Contractor and License No.

Signature of Water Well Contractor

RECEIVED

JUL 03 2007

BY: OLWF

STATE WELL REPORT

Part 2

Pump Installer's Completion Report
Mississippi Department of Environmental Quality
Office of Land and Water Resources
P.O. Box 10631
Jackson, MS 39289-0631
(601)961-5210
(601)354-6938 (fax)

County: Sunflower
Permit #: GW 41908
Driller: Irrigation Equipment
Date completed: 6-29-07

For Office Use Only:

Aquifer: _____
Well #: G-133
Elevation: _____

This report should be prepared by the pump installer in detail and filed with the Department within 30 days of the installation of pump.

Well Owner Information	Well Location
Owner Name: <u>G + G Farms</u>	Latitude: _____ Longitude: _____
Mailing Address: <u>918 Hwy 442</u>	Method of Lat/Long (circle one): Conventional Survey, USGS quad, Hand-held GPS, Survey-grade GPS
<u>Shaw</u> <u>Ms.</u> <u>38773</u> City State Zip Code	<u>1/4 SW 1/4 Sec 23 Twn 21N Rng 4W</u>
Telephone No. () _____	Distance Direction Nearest Town <u>4 Miles W of Doddsville</u>

Pump Type Circle one	Power Type Circle one
Air Lift Jet <u>Submersible</u>	Diesel Engine Gasoline Engine Natural Gas
Bucket Piston Turbine	<u>Electric Motor</u> Hand Tractor PTO
Centrifugal Rotary Flowing Well	Windmill Other (specify): _____
Other (specify): _____	Horse Power Rating of Motor: <u>10</u>
Date Pump Installed: <u>6-29-07</u>	Setting Depth: <u>80</u> feet
Rated Pump Capacity: <u>500 ±</u> Gallons Per Minute	Number of Stages: <u>1</u>

Pump Test Data	Method of Measuring Water Level Circle one
Date Well Tested: _____	Air Line Electric Measuring Line Steel Tape
Static Water Level (A): _____ Feet Below Land Surface	Other (specify): _____
Pumping Water Level (B): _____ Feet Below Land Surface	For flowing well, measured shut in head: _____ feet
Drawdown [(B) - (A)]: _____ Feet Below Land Surface	Well yielded _____ GPM with a drawdown of _____ feet after _____ hours of pumping
Test Pumping Rate: _____ Gallons Per Minute	
Duration of Pump Test (minimum 4 hours): _____ hours	

I HEREBY CERTIFY that the above statements are true to the best of my knowledge.

Patrick M. Chism 0695
Print Name of Pump Installer and License No. (if applicable)

Patrick M. Chism
Signature of Pump Installer

RECEIVED

JUL 09 2007



BY: OLWR

GW41908

G-133

G+G Farms Map

Y

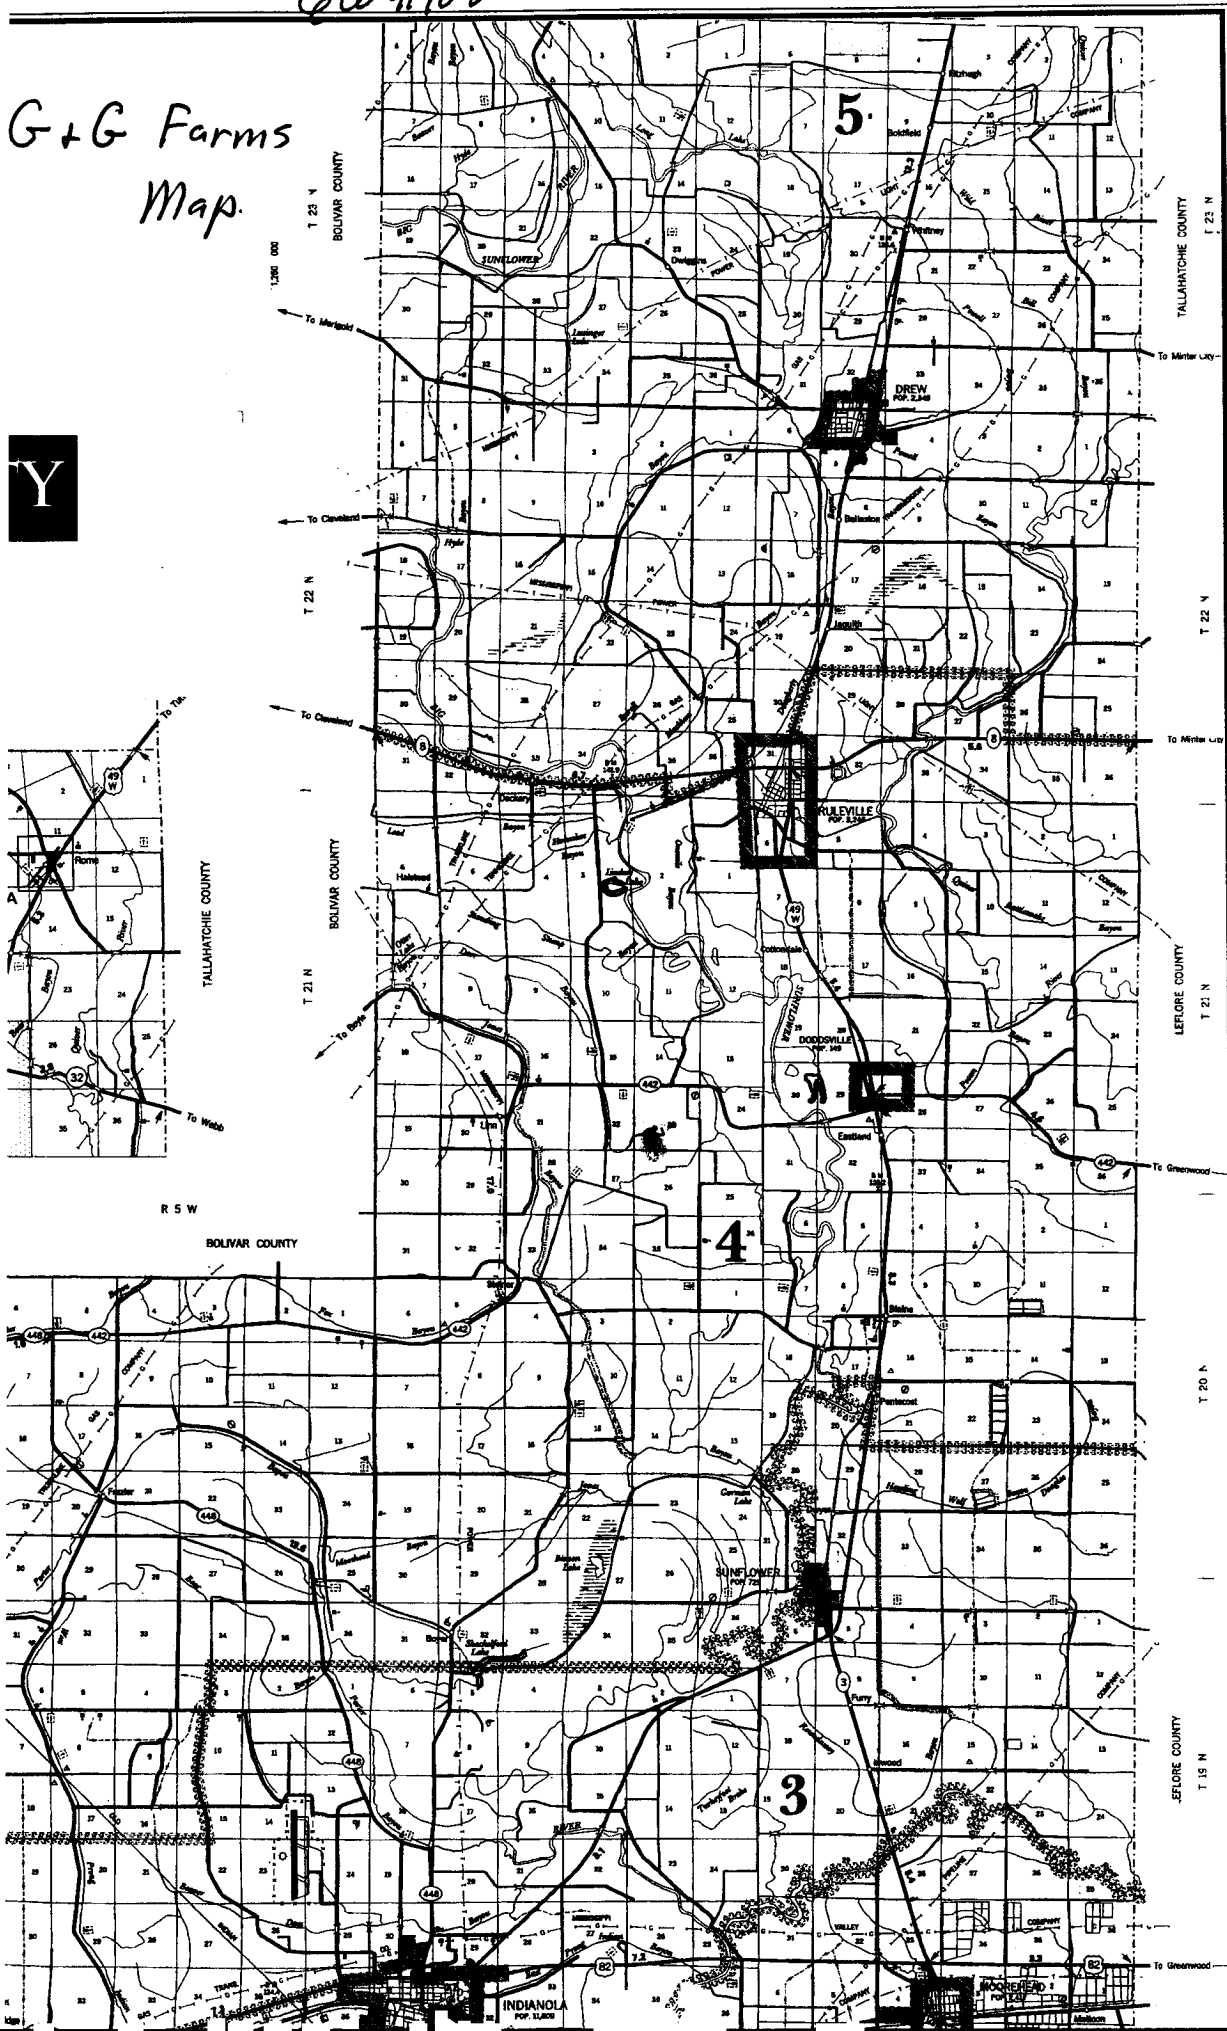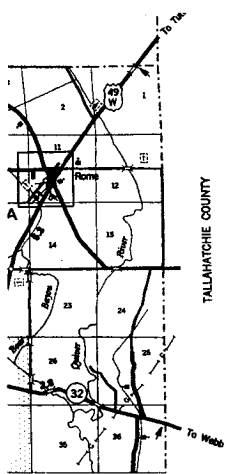

RECEIVED
 JUL 09 2007
 BY: OLWR