

County: Sunflower
 Rank #: GW-45000
 Irrigation Equipment
 Date drilling completed: 2-23-11

State Well Report
Part 1 - Driller's Log
 Mississippi Department of Environmental Quality
 Office of Land and Water Resources
 P.O. Box 2309
 Jackson, MS 39225
 (601)961-5210
 (601)961-5228 (fax)

For Office Use Only:
 Aquifer: 6157
 Well #: _____
 I. S. Elevation: _____
 E-log #: _____

State Law requires that this report be prepared by the license holder responsible for the work and filed with the Department at the above address within 30 days of completion of drilling of the well or borehole.

<p>Information on Well Owner (Landowner if borehole is not for a water well)</p> <p>Owner Name: <u>Bonita Metcalf</u> Mailing Address: <u>520 Hillcrest Circle</u> <u>Cleveland Ms. 38732</u> City State Zip Code Telephone No. () _____</p>	<p>Well or Borehole Location</p> <p>Latitude: <u>33.40.01.2</u> Longitude: <u>90.37.39.0</u> Method of Lat/Long (circle one): Conventional Survey USGS quad, <u>Hand-held GPS</u> Survey-grade GPS <u>NE 1/4 SE 1/4 Sec. 17 Twn 21N Rng 4W</u> Distance Direction Nearest Town <u>1</u> Miles <u>NW</u> of <u>Linn</u></p>
---	--

Well / Borehole Data

Date drilling started: 2-23-11 Date drilling completed: 2-23-11 Hole depth: 127 Hole diameter: 24"

Location of the source of any surface water used for drilling: Surface Water
 Method of dosing and volume of Chlorine used in drilling and development: 50 PPM

Logs run (circle all applicable): No log run Electric Gamma Ray Density Sonic Neutron Other: _____
 Name of organization running log(s): _____

Purpose of borehole (check one): Water Well Geotechnical/Geological Investigation _____ Ground Source Heat Pump _____
 Scientific Survey _____ Other (describe) _____

If driller is not related to water well construction, fill the remainder of this block

Purpose of Well (check one): Home _____ Industrial _____ Public Supply _____ Irrigation Fish Culture _____ Other: _____

If a flowing well, method of flow regulation: Valve _____ Other (describe) _____

Static Water Level: 52 feet above of below (circle one) land surface Date measured: 2-24-11

Method of Measurement (circle one): steel tape electric tape air line other: _____

Well depth: 127 Well grouted to a depth of 10 feet Type of grout (circle one): Neat Cement Bentonite Mix
 Casing length: 87 feet Casing diameter: 16 inches Type of casing: PVC
 Screen length: 40 feet Screen diameter: 16 inches Type of screen: PVC
 Screen slot size: .050 inches Setting depth: From 88 feet to 127 feet

Type of completion (circle all applicable): Gravel packed Underreamed Telescoped Open hole Natural Development
 Other (describe): _____

Top of lap pipe or reduction in casing: _____ feet *If telescoped or more than one screen, describe on next page*

Form: OLWR-SWR-1A (04/06)


RECEIVED
 MAR 04 2011
 BY: OLWR

G157

The sketch below only required for water wells

Description of formations encountered must be provided for all wells and boreholes, unless specifically exempted by regulations

If well telescopes, show depths on sketch

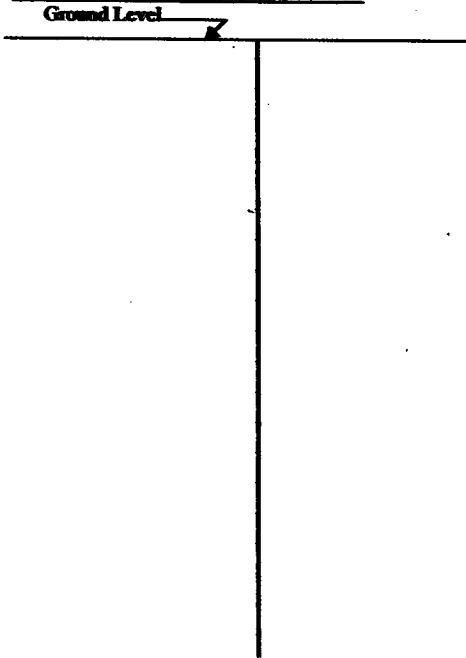

Description of Formations Encountered	From (depth)	To (depth)
Clay	Ground Level	22
Fine Sand	23	27
Fine Sand + Gravel	28	42
Medium Sand	43	57
Medium Sand + Gravel	58	87
Course Sand + Gravel	88	127

If more than one screen, show location of each on sketch

Sketch the property layout and include the following: 1) the well location; 2) any permanent structures on the property that may aid in locating the well; 3) any roads, power lines, or other items that may aid in locating the property and the well; 4) a north arrow.

Landowner Name: Bonita Metcalf

Form: OLWR-SWR-1A (04/08)

I certify that the well/borehole was drilled, constructed, and completed in accordance with all applicable requirements of the Mississippi Department of Environmental Quality and the Mississippi Department of Health regulations, if applicable, and state laws.

Patrick M Chism 0695 *Patrick M Chism*

Print Name of Responsible Licensee and License No. Date Signature of Licensee

RECEIVED

MAR 04 2011

BY: OLWR

County: Sunflower
 Permit #: GW-45000
 Irrigation Equipment
 Driller: _____
 Date completed: 2-23-11
 Copy information from Block on Part I

STATE WELL REPORT
Part 2
 Pump Installer's Completion Report
 Mississippi Department of Environmental Quality
 Office of Land and Water Resources
 P.O. Box 2309
 Jackson, MS 39225
 (601)961-5210
 (601)961-5228 (fax)

For Office Use Only:
 Aquifer: _____
 Well #: G157
 Elevation: _____

This part of the report must be completed by a licensed water well contractor or a licensed pump installer. A copy of Part 1 of the report must be attached and both parts filed with the Department at the above address within 30 days of well completion.

Well Owner Information	Well Location
Owner Name: <u>Bonita Metcalf</u>	Latitude: _____ Longitude: _____
Mailing Address: <u>520 Hillcrest Circle</u>	Method of Lat/Long (check one): Conventional Survey _____
<u>Cleveland Ms. 38732</u>	USGS quad _____, Hand-held GPS <input checked="" type="checkbox"/> , Survey-grade GPS _____
City State Zip Code	<u>NE 1/4 SE 1/4 Sec 17 T 21 N R 4 W</u>
Telephone No. () _____	Distance _____ Direction _____ Nearest Town _____
	<u>1</u> Miles <u>NW</u> of <u>Linn</u>

Pump Type	Power Type
Circle one	Circle one
Air Lift: Jet <input type="checkbox"/> Submersible <input type="checkbox"/>	<u>Diesel Engine</u> Gasoline Engine Natural Gas
Bucket: Piston <input type="checkbox"/> <u>Turbine</u> <input type="checkbox"/>	Electric Motor Hand <input checked="" type="checkbox"/> Tractor PTO
Centrifugal: Rotary <input type="checkbox"/> Flowing Well <input type="checkbox"/>	Windmill Other (specify): _____
Other (specify): _____	Horse Power Rating of Motor: <u>60</u>
Date Pump Installed: <u>2-24-11</u>	Setting Depth: <u>80</u> feet
Rated Pump Capacity: <u>2300 ±</u> Gallons Per Minute	Number of Stages: <u>2</u>

Pump Test Data	Method of Measuring Water Level
Date Well Tested: _____	Circle one
Static Water Level (A): _____ Feet Below Land Surface	Air Line Electric Measuring Line Steel Tape
Pumping Water Level (B): _____ Feet Below Land Surface	Other (specify): _____
Drawdown [(B) - (A)]: _____ Feet Below Land Surface	For flowing well, measured shut in head: _____ feet
Test Pumping Rate: _____ Gallons Per Minute	Well yielded _____ GPM with a drawdown of _____ feet after _____ hours of pumping
Duration of Pump Test (minimum 4 hours): _____ hours	

This is for (circle one): New Well Replacement of Existing Pump Repair of Existing Pump

I HEREBY CERTIFY that the above statements are true to the best of my knowledge.
 Patrick M Chism 0695
 Print Name of Pump Installer and License No. (if applicable) Signature of Pump Installer

Form: OLWR-SWR-16 (07-09)

RECEIVED
 MAR 04 2011
 BY: OLWR