	STATE WELL R	REPORT	For Office	Use Only
County: Sunflower	Part 1		Well #: <u>G18</u>	66
Permit #: GW-48503	Driller's Lo)g	Aquifer:	
Driller: Irrigation Equipment	Mississippi Department of Env Office of Land and Wate	r Resources		
Date drilling completed: 09/09/2014	P.O. Box 230 Jackson, MS 3922			
	(601) 961-521 (601) 360-0535 (
State Law requires that this report	. ,		or the work and fil	led with t
Department at the above address v	vithin 30 days of completion of	f drilling of the w	ell or borehole.	
Well Owner Informa (Landowner if borehole is not fo		Well or E	Borehole Location	
Owner Name: Kathy Holmes	Latitude:	33 40' 05.6 N	Longitude: 90 3	4' 33.3 W
Mailing Address: 27 Bobby Hearn Ro	And Method of Me	of Lat/Long (check o	one): 🔲 Conventio	nal Survey
		S quad, 🛛 Hand-he	eld GPS, 🔲 Survey-g	rade GPS
Doddsville Ms	38736	<u>SW</u> ½ <u>NÉ</u> ½	, Sec <u>14</u> T <u>21 N</u> R <u>41</u>	W
City Stat				
Telephone No. () -	3 (Dista		•••	oddsville rest Town)
	Well / Borehole Dat	a		
Method of dosing and volume of Chlorine Logs run (check all applicable): X No log Name of organization running log(s):	g run 🔲 Electric 🗋 Gamma Ray 🗍			
Logs run (check all applicable): 🛛 No log	g run 🔲 Electric 🗋 Gamma Ray 🗍] Density 🗌 Sonic		
Logs run (check all applicable): 🛛 No log Name of organization running log(s): Purpose of borehole (check one): 🖾 W	g run 🗌 Electric 🗋 Gamma Ray 🗍] Density [] Sonic ogical Investigation		e Heat Pur
Logs run (check all applicable): 🛛 No log Name of organization running log(s): Purpose of borehole (check one): 🖾 W	g run 🗌 Electric 🗋 Gamma Ray 🗍	Density D Sonic ogical Investigation	Ground Source	e Heat Pur
Logs run (check all applicable): 🛛 No log Name of organization running log(s): Purpose of borehole (check one): 🖾 W	g run Electric Gamma Ray	Density D Sonic ogical Investigation cribe)	Ground Source	e Heat Pur
Logs run (check all applicable): No log Name of organization running log(s): Purpose of borehole (check one): N <i>If drilling is not rel</i> Purpose of Well (check all applicable):	g run Electric Gamma Ray ater Well Geotechnical/Geol seismic Survey Other (des ated to water well construction Home Industrial Public Supp	Density D Sonic ogical Investigation cribe) , skip the remain	Ground Source ader of this block	e Heat Pur
Logs run (check all applicable): 🛛 No log Name of organization running log(s): Purpose of borehole (check one): 🖾 W 🗌 S <i>If drilling is not rel</i> Purpose of Well (check all applicable): ☐ Other (<i>describe</i>):	g run Electric Gamma Ray	Density D Sonic ogical Investigation cribe) of skip the remain	Ground Source ader of this block ish Culture	e Heat Pun
Logs run (check all applicable): ⊠ No log Name of organization running log(s): Purpose of borehole (check one): ⊠ W □ S If drilling is not rel. Purpose of Well (check all applicable): □ □ Other (describe): If a flowing well, method of flow regulation	g run Electric Gamma Ray	Density D Sonic ogical Investigation cribe) s, skip the remain oly Irrigation D F	Ground Source ader of this block	e Heat Pur
Logs run (check all applicable): 🛛 No log Name of organization running log(s): Purpose of borehole (check one): 🖾 W 🗌 S <i>If drilling is not rel</i> Purpose of Well (check all applicable): ☐ Other (<i>describe</i>):	g run Electric Gamma Ray	Density D Sonic ogical Investigation cribe) s, skip the remain oly Irrigation D F	Ground Source ader of this block	e Heat Pur
Logs run (check all applicable): ⊠ No log Name of organization running log(s): Purpose of borehole (check one): ⊠ W □ S If drilling is not rel Purpose of Well (check all applicable): □ □ Other (describe): If a flowing well, method of flow regulation	g run 🗌 Electric 🗌 Gamma Ray 🗐 later Well 📄 Geotechnical/Geol seismic Survey 📄 Other (<i>des</i> <u>ated to water well construction</u> Home 🗌 Industrial 📄 Public Supp n: Valve Other (<i>des</i> eet [] above or 🛛 below] land sur (check one)	Density Density Sonic ogical Investigation cribe) of skip the remain bly Irrigation D F describe) face Date me	Ground Source ader of this block ish Culture asured: 09/10/2014	e Heat Pur
Logs run (check all applicable): ⊠ No log Name of organization running log(s): Purpose of borehole (check one): ⊠ W □ S <i>If drilling is not rel</i> Purpose of Well (check all applicable): □ Other (describe): If a flowing well, method of flow regulation Static Water Level: 52'	g run 🗌 Electric 🗌 Gamma Ray 🗐 later Well 📄 Geotechnical/Geol seismic Survey 📄 Other (des ated to water well construction Home 🗌 Industrial 📄 Public Supp n: Valve Other (des ceet [] above or 🖾 below] land sur (check one) Steel tape 🗋 Electric tape 🗋 Air lir	Density Sonic ogical Investigation cribe) , skip the remain by Irrigation F describe) face Date me be Other: (descri	Ground Source ader of this block ish Culture asured: 09/10/2014 ibe)	e Heat Pur
Logs run (check all applicable): ⊠ No log Name of organization running log(s): Purpose of borehole (check one): ⊠ W □ S <i>If drilling is not rel</i> Purpose of Well (check all applicable): □ Other (describe): If a flowing well, method of flow regulation Static Water Level: 52'f Method of Measurement (check one) ⊠	g run Electric Gater Well Geotechnical/Geol Geismic Survey Other (destated to water well construction Home Industrial Home Industrial Public Supp n: Valve (check one) Steel tape Electric tape Air lin depth of: 10'	Density Sonic ogical Investigation cribe) , skip the remain by Irrigation F describe) face Date me ne Other: (descri grout (check one): [Ground Source ader of this block ish Culture asured: 09/10/2014 ibe) □ Neat Cement ⊠ B	e Heat Pur
Logs run (check all applicable): ⊠ No log Name of organization running log(s): Purpose of borehole (check one): ⊠ W □ S <i>If drilling is not rel</i> Purpose of Well (check all applicable): □ Other (describe): □ Other (describe): If a flowing well, method of flow regulation Static Water Level: 52' Method of Measurement (check one) ⊠ Well depth: 127' Well grouted to a Casing length: 87' feet	g run Electric Gater Well Geotechnical/Geol Geismic Survey Other (destated to water well construction Home Industrial Home Industrial Public Supp n: Valve (check one) Steel tape Electric tape Air lin depth of: 10'	Density Sonic ogical Investigation ocribe) cribe) ogical Investigation ogical Investigation <td< td=""><td>Ground Source ader of this block ish Culture asured: 09/10/2014 ibe) □ Neat Cement ⊠ B of casing: PVC</td><td>e Heat Pun</td></td<>	Ground Source ader of this block ish Culture asured: 09/10/2014 ibe) □ Neat Cement ⊠ B of casing: PVC	e Heat Pun
Logs run (check all applicable): ⊠ No log Name of organization running log(s): Purpose of borehole (check one): ⊠ W □ S <i>If drilling is not rel</i> Purpose of Well (check all applicable): □ □ Other (describe): □ Other (describe): If a flowing well, method of flow regulation Static Water Level: 52'f Method of Measurement (check one) ⊠ Well depth: 127' Well grouted to a Casing length: 87' feet	g run Electric Gater Well Geotechnical/Geolectric Geismic Survey Other (destriction) Gated to water well construction Home Industrial Home Industrial Public Supp n: Valve Other (destriction) n: Valve Other (destriction) Steel tape Electric tape Air lindepth of: 10* Screen diameter: 10*	Density Sonic ogical Investigation ocribe) cribe) ogical Investigation ogical Investigation <td< td=""><td>Ground Source ader of this block ish Culture asured: 09/10/2014 ibe) □ Neat Cement ⊠ B of casing: PVC of screen: PVC</td><td>e Heat Pur</td></td<>	Ground Source ader of this block ish Culture asured: 09/10/2014 ibe) □ Neat Cement ⊠ B of casing: PVC of screen: PVC	e Heat Pur
Logs run (check all applicable): ⊠ No log Name of organization running log(s): Purpose of borehole (check one): ⊠ W □ S <i>If drilling is not rel</i> Purpose of Well (check all applicable): □ □ Other (describe): □ Other (describe): If a flowing well, method of flow regulation Static Water Level: <u>52'</u> f Method of Measurement (check one) ⊠ Well depth: <u>127'</u> Well grouted to a Casing length: <u>87'</u> feet Screen length: <u>40'</u> feet	a run ☐ Electric ☐ Gamma Ray ☐ ater Well ☐ Geotechnical/Geol Beismic Survey ☐ Other (des ated to water well construction Home ☐ Industrial ☐ Public Supp h: Valve Other (des ceet [] above or ⊠ below] land sur (check one) Steel tape ☐ Electric tape ☐ Air lin depth of: 10' feet Type of g Casing diameter: 10" Screen diameter: 10" aches Setting depth: From	Density Sonic ogical Investigation cribe)	Ground Source ader of this block ish Culture asured: 09/10/2014 ibe) ☐ Neat Cement ⊠ B of casing: PVC of screen: PVC feet to 127'	e Heat Pur
Logs run (check all applicable): ⊠ No log Name of organization running log(s): Purpose of borehole (check one): ⊠ W □ S <i>If drilling is not rel</i> Purpose of Well (check all applicable): □ Other (describe): □ Other (describe): If a flowing well, method of flow regulation Static Water Level: 52' Method of Measurement (check one) Well depth: 127' Well depth: 127' Screen length: 40' feet Screen slot size: .050 in Type of completion (check all applicable):	a run ☐ Electric ☐ Gamma Ray ☐ ater Well ☐ Geotechnical/Geol Beismic Survey ☐ Other (des ated to water well construction Home ☐ Industrial ☐ Public Supp h: Valve Other (des ceet [] above or ⊠ below] land sur (check one) Steel tape ☐ Electric tape ☐ Air lin depth of: 10' feet Type of g Casing diameter: 10" Screen diameter: 10" aches Setting depth: From	Density Sonic ogical Investigation ocribe) ocribe ocrib	Ground Source ader of this block ish Culture asured: 09/10/2014 ibe) □ Neat Cement ⊠ B of casing: PVC of screen: PVC feet to 127' Natural Development	e Heat Pun
Logs run (check all applicable): ⊠ No log Name of organization running log(s): Purpose of borehole (check one): ⊠ W □ S <i>If drilling is not rel</i> Purpose of Well (check all applicable): □ □ Other (describe): □ Other (describe): If a flowing well, method of flow regulation Static Water Level: <u>52'</u> f Method of Measurement (check one) ⊠ Well depth: <u>127'</u> Well grouted to a Casing length: <u>87'</u> feet Screen length: <u>40'</u> feet Screen slot size: <u>.050</u> in Type of completion (check all applicable):	g run Electric Gamma Ray gater Well Geotechnical/Geolectric iseismic Survey Other (destated to water well construction iseismic Survey Other (destated to water well construction Home Industrial Home Industrial Public Supp n: Valve Other (destated to water well construction home Industrial Public Supp n: Valve Other (destated to water well construction home Industrial Public Supp n: Valve Other (destated to water well construction home Industrial Public Supp n: Valve Other (destated to water well construction indepth of: 10" Gasing diameter: 10" Screen diameter: 10" inches Setting depth: From 2 inches Setting depth:	Density Sonic ogical Investigation ocribe) ocribe ocrib	Ground Source ader of this block ish Culture asured: 09/10/2014 ibe) □ Neat Cement ⊠ B of casing: PVC of screen: PVC feet to 127' Natural Development	e Heat Pur

	For Office Use Only:
Well#:	G188


The sketch below only required for water wells

If well telescopes, show depths on sketch.

County: Sunflower
Permit #: GW-48503

1

ł

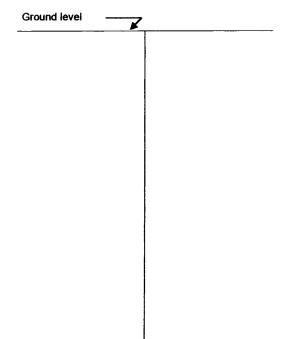

<u>Description of formations encountered must be provided for all wells</u> <u>and boreholes, unless specifically exempted by regulations</u>

Description of Formations Encountered	From (depth)	To (depth)
Clay	Ground level	84
Medium Sand & Gravel	85	127
<u>.</u>		
· · · · · · · · · · · · · · · · · · ·		
		·
		2
		1
	1	
		
	1	I

If more than one screen, show location of each on sketch

Sketch the property la	ayout and include the following:			
1) the well locati	on			
2) any permaner	nt structures on the property that r	may aid in locating th	e well	
3) any roads, po	wer lines, or other items that may	aid in locating the pr	roperty and the well	
4) a north arrow				
				an far har a sea a th
				SEP 1 5 2014
				JEF 1 0 2014
Landowner Name:	Kathy Holmes			
I HEREBY CERTIEY	that the well/borehole was drilled,	constructed and co		Form: OLWR-SWR-1A(0)(0B)
	lississippi Department of Environm			
if applicable, and state	e laws.	,		
Patrick Chism	0695	09/10/2014	Ta	
Print Name of Respo	nsible Licensee and License No.	Date	Sigi	nature of Licensee
				Form: OLWR-SWR-1A (4/13)

· · · · · · · · · · · · · · · · · · ·	STATE WELL REPORT	For Office Use Only:
County: Sunflower	Part 2	Well#: <u>G188</u>
Permit #: GW-48503	Pump Installer's Completion Report	
Driller: Irrigation Equipment	Mississippi Department of Environmental Quality Office of Land and Water Resources	Aquifer:
Date drilling completed: 09/09/2014	P.O. Box 2309	
Copy information from block on Part 1	Jackson, MS 39225-2309 (601) 961-5210	<u></u>
	(601) 360-0535 (fax)	
	d by a licensed water well contractor or a licensed pum	
of the report must be attached and both Well Owner informa	parts filed with the Department at the above address wi tion We	thin 30 days of well completion. Ell Location
		Longitude: 90 34' 33.3 W
Mailing Address: 27 Bobby Hearn Ro	Ad Method of Lat/Long (check (one): Conventional Survey,
Malling Address. <u>It bobby from the</u>		
	USGS quad, 🛛 Hand-he	eld GPS, 🔲 Survey-grade GPS
Doddsville Ms	38736 <u>SW</u> ½ <u>NE</u> ½	Sec <u>14</u> T <u>21 N</u> R <u>4 W</u>
City Stat	e Zip code	
Telephone No. () -		est of Doddsville (Nearest Town)
	Pump Type (check one)	
🛛 Submersible 🗌 Turbine 🗋 Air Lift 🗌 🤇	Centrifugal 🗋 Flowing Well 🗋 Jet 🗋 Piston 🗋 Rotary	Other (describe):
Date Pump Installed 09/10/2014	Rated Pump Capacity:	Gallons Per Minute
ls This Pump (check one): 🛛 New 🗌 Re	enaired 🗍 Replacement	
	Power Type (check one)	
⊠ Electric □ Diesel □ Gasoline □ Natu	Power Type (check one) Iral Gas 🔲 Tractor PTO 🗋 Windmill 🔲 Other (describe	
⊠ Electric □ Diesel □ Gasoline □ Natu	Power Type (check one)	
⊠ Electric □ Diesel □ Gasoline □ Natu	Power Type (check one) Iral Gas [] Tractor PTO [] Windmill [] Other (describe Setting Depth:feet 1	
☑ Electric ☐ Diesel ☐ Gasoline ☐ Natu Horse Power Rating of Motor: _10	Power Type (check one) Iral Gas Tractor PTO Windmill Other (describe Setting Depth: 80° feet Pump Test Data for Non Flowing Well	Number of Stages: _1
Image: Second contract of the second contract on the second	Power Type (check one) Iral Gas I Tractor PTO I Windmill Other (describe Setting Depth: 80' feet M Pump Test Data for Non Flowing Well Duration of Pump Test (mini	Number of Stages: _1 mum 4 hours): Hours
Electric Diesel Gasoline Nature Horse Power Rating of Motor: 10 Date Well Tested: Static Water Level (A): Fe	Power Type (check one) Iral Gas Tractor PTO Windmill Other (describe Setting Depth: 80° Fump Test Data for Non Flowing Well Duration of Pump Test (mini eet Below Land Surface Pumping Water Level (B):	Number of Stages: mum 4 hours): Hours Feet Below Land Surface
☑ Electric □ Diesel □ Gasoline □ Natu Horse Power Rating of Motor: 10 Date Well Tested: Static Water Level (A):	Power Type (check one) Iral Gas I Tractor PTO I Windmill Other (describe Setting Depth: 80' feet M Pump Test Data for Non Flowing Well Duration of Pump Test (mini	Number of Stages: mum 4 hours): Hours Feet Below Land Surface
☑ Electric □ Diesel □ Gasoline □ Natu Horse Power Rating of Motor: Date Well Tested: Static Water Level (A): Featore Drawdown [(B) - (A)]:	Power Type (check one) Iral Gas Tractor PTO Windmill Other (describe Setting Depth: 80° Fump Test Data for Non Flowing Well Duration of Pump Test (mini eet Below Land Surface Pumping Water Level (B):	Number of Stages: mum 4 hours): Hours Feet Below Land Surface Gallons Per Minute
Image: Static Water Level (A):	Power Type (check one) aral Gas Tractor PTO Windmill Other (describe Setting Depth: 80' Fump Test Data for Non Flowing Well Duration of Pump Test (mini eet Below Land Surface Feet Below Land Surface Feet Below Land Surface Feet Pumping Rate:	Number of Stages: mum 4 hours): Hours Feet Below Land Surface Gallons Per Minute
Image: Static Water Level (A):	Power Type (check one) aral Gas Tractor PTO Windmill Other (describe	Number of Stages: mum 4 hours): Hours Feet Below Land Surface Gallons Per Minute
☑ Electric □ Diesel □ Gasoline □ Natu Horse Power Rating of Motor: Date Well Tested: Static Water Level (A): Drawdown [(B) - (A)]: Method of measurement (check one): □ Measured shut in head:	Power Type (check one) aral Gas Tractor PTO Windmill Other (describe	Number of Stages: _1 mum 4 hours): Hours Feet Below Land Surface Gallons Per Minute be):
☑ Electric □ Diesel □ Gasoline □ Natu Horse Power Rating of Motor: Date Well Tested: Static Water Level (A): Feasured of measurement (check one): □ Measured shut in head:	Power Type (check one) aral Gas Tractor PTO Windmill Other (describe	Number of Stages: _1 mum 4 hours): Hours Feet Below Land Surface Gallons Per Minute be):
Image: Static Water Level (A):	Power Type (check one) aral Gas Tractor PTO Windmill Other (describe	Number of Stages: _1 mum 4 hours): Hours Feet Below Land Surface Gallons Per Minute be):
☑ Electric □ Diesel □ Gasoline □ Natu Horse Power Rating of Motor: 10 Date Well Tested: Static Water Level (A): Fe Drawdown [(B) - (A)]: Method of measurement (check one): □ Measured shut in head: Well yielded GPM with	Power Type (check one) Iral Gas Tractor PTO Windmill Other (describe Setting Depth: 80° feet N Pump Test Data for Non Flowing Well Duration of Pump Test (mini Det Below Land Surface Pumping Water Level (B): Feet Below Land Surface Test Pumping Rate: Steel tape Electric tape Air line Other (describe) Pump Test Data for Flowing Well	Number of Stages: _1 mum 4 hours): Hours Feet Below Land Surface Gallons Per Minute be):
Electric Diesel Gasoline Natures Horse Power Rating of Motor:10 Date Well Tested: Static Water Level (A): Fe Drawdown [(B) - (A)]: Method of measurement (check one): Measured shut in head: Well yielded GPM with Meter Manufacturer:	Power Type (check one) Iral Gas Tractor PTO Windmill Other (describe Setting Depth: 80° feet N Pump Test Data for Non Flowing Well Duration of Pump Test (mini Det Below Land Surface Pumping Water Level (B): Feet Below Land Surface Test Pumping Rate: Steel tape Electric tape Air line Other (describe) Pump Test Data for Flowing Well	Number of Stages: _1 mum 4 hours): Hours Feet Below Land Surface Gallons Per Minute be): hours of pumping
Electric Diesel Gasoline Natures Horse Power Rating of Motor: 10 Date Well Tested: Static Water Level (A): Fe Drawdown [(B) - (A)]: Method of measurement (check one): Measured shut in head: Well yielded GPM with Meter Manufacturer: Meter Model Number/Name:	Power Type (check one) Iral Gas Tractor PTO Windmill Other (describe Setting Depth: 80' feet N Pump Test Data for Non Flowing Well Duration of Pump Test (mini Duration of Pump Test (mini Duration of Pump Test (mini Eet Below Land Surface Pumping Water Level (B):	Number of Stages: 1 mum 4 hours): Hours Feet Below Land Surface Gallons Per Minute be): hours of pumping
	Power Type (check one) tral Gas Tractor PTO Windmill Other (describe	Number of Stages: _1 mum 4 hours): Hours Feet Below Land Surface Gallons Per Minute be): hours of pumping
☑ Electric □ Diesel □ Gasoline □ Natu Horse Power Rating of Motor: _10 Date Well Tested: Static Water Level (A): Fe Drawdown [(B) - (A)]: Method of measurement (check one): □ Measured shut in head: Well yielded GPM with Meter Manufacturer: Meter Model Number/Name: Totalizer Register Unit and Multiplier Fac Installation Date:	Power Type (check one) Iral Gas Tractor PTO Windmill Other (describe Setting Depth: 80' feet N Pump Test Data for Non Flowing Well Duration of Pump Test (mini Duration of Pump Test (mini Duration of Pump Test (mini eet Below Land Surface Pumping Water Level (B):	Number of Stages: _1 mum 4 hours): Hours Feet Below Land Surface Gallons Per Minute be): hours of pumping
☑ Electric □ Diesel □ Gasoline □ Natu Horse Power Rating of Motor: 10 Date Well Tested:	Power Type (check one) Iral Gas Tractor PTO Windmill Other (describe Setting Depth: 80' feet N Pump Test Data for Non Flowing Well Duration of Pump Test (mini Duration of Pump Test (mini Duration of Pump Test (mini eet Below Land Surface Pumping Water Level (B):	Number of Stages: 1 mum 4 hours):
☑ Electric □ Diesel □ Gasoline □ Natu Horse Power Rating of Motor: _10 Date Well Tested:	Power Type (check one) aral Gas Tractor PTO Windmill Other (describe	Number of Stages: 1 mum 4 hours):
☑ Electric □ Diesel □ Gasoline □ Natu Horse Power Rating of Motor: _10 Date Well Tested:	Power Type (check one) aral Gas [] Tractor PTO [] Windmill [] Other (describe Setting Depth: 80' feet N Pump Test Data for Non Flowing Well Duration of Pump Test (mini eet Below Land Surface Pumping Water Level (B): Feet Below Land Surface Test Pumping Rate: Steel tape [] Electric tape [] Air line [] Other (describe Pump Test Data for Flowing Well Feet a drawdown of feet after Meter Installation Type of Meter: T	Number of Stages: 1 mum 4 hours):

•