

MISSISSIPPI DEPARTMENT OF NATURAL RESOURCES

Bureau of Land and Water Resources

P.O. Box 10631

Jackson, Mississippi 39209

WATER WELL DRILLERS LOG

COUNTY WELL LOCATED Sunflower	
WELL NUMBER G	CODED
2003	
DATE WELL COMPLETED April 8, 1989	

12.713

PERMIT NUMBER
NAME OF DRILLING FIRM McChains Pump Service

NAME & MAILING ADDRESS OF LANDOWNER Mrs. Keith Dockery McLean Cleveland, Ms (601) 756-2202		
WELL LOCATION: SEC	TOWNSHIP	RANGE
4	21	N 4 E
DISTANCE	DIRECTION	NEAREST TOWN
_____ Miles	_____ of	_____
OTHER LANDMARK		
WELL PURPOSE: Home, <u>Irrigation</u> , Municipal, Industrial, Fish Pond, etc.		

PUMP DATA		
PUMP TYPE (Circle One): Submersible, <u>Turbine</u> , Jet, Flowing Well, Other (Describe) _____		
POWER TYPE (Circle One): Electric, Tractor, <u>Diesel</u> , Gasoline, Butane, Other (Describe) _____		
Pump Capacity (GPM) 1500	No. of Stages 2	Setting Depth 60 FT.
PUMP TEST		
Well yielded _____ GPM with a drawdown of _____ ft. after _____ hours of pumping		

WELL DATA		
Well Depth 117	Casing Diameter (In.) 12 in.	Casing Length (Ft.) 77
Type of Casing Steel	Hole Depth 117	Depth to Static Water Level 37 ft
TYPE OF COMPLETION: (Circle One or More): <u>Gravel Packed</u> , Underreamed, Telescoped, Natural Development, Open Hole, Other		
Top of Lap Pipe or Reduction in Casing		
FEET IF TELESCOPED OR MORE THAN ONE SCREEN: USE BACK PAGE		

LOG DATA	
TYPE OF LOG RUN (Circle One): No Log Run, Electric, Gamma Ray, Density, Sonic, Neutron, Other (Describe) _____	
Name of Organization Running Log	

SCREEN DATA		
Diameter - Inches 12 in	Length - Feet 40 ft	Slot Size - Inches 50
Screen Type Steel		Depth to Bottom - Feet 117

GEOLOGIC DATA (Office Use Only)			
Surface Elev.	Geologic Unit	Unit Thickness	Depth to Top
Subs. SWL	Date	Analysis	Aquifer Test
Driller's Remarks			

DESCRIPTION OF FORMATIONS ENCOUNTERED	FROM	TO
Top Soil	0	14
Clay & fine Sand	14	40
Coarse Sand	40	67
Coarse Sand & Gravel	67	117

RECEIVED


MAY 10 1989

Department of Natural Resources
Bureau of Land & Water Resources

IF MORE SPACE IS NEEDED, USE BACK

If well telescopes please sketch and show depths.

GROUND LEVEL

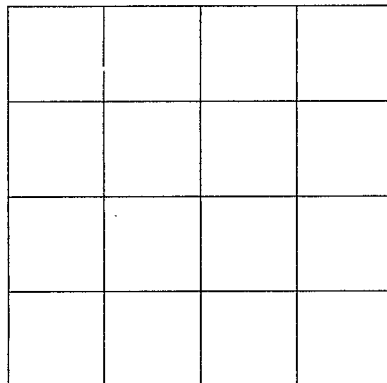

SECTION _____

Please indicate well location X.

ADDITIONAL INFORMATION

If more than one screen,
show location of each on sketch.