

MISSISSIPPI DEPARTMENT OF NATURAL RESOURCES

Bureau of Land and Water Resources

COUNTY WELL LOCATED Sunflower	
WELL NUMBER G	CODED
2009	
DATE WELL COMPLETED June 23, 92	

PERMIT NUMBER
NAME OF DRILLING FIRM McChains Pump Service

127A

P.O. Box 10631
Jackson, Mississippi 39209
WATER WELL DRILLERS LOG

NAME & MAILING ADDRESS OF LANDOWNER Givens			
509 Canal Ave			
Cleveland MS 38732			
WELL LOCATION:	SEC 8	TOWNSHIP 21 S	RANGE 4 E
DISTANCE	DIRECTION	NEAREST TOWN	
_____ Miles	_____ of _____		
OTHER LANDMARK			
WELL PURPOSE: Home, <u>Irrigation</u> , Municipal, Industrial, Fish Pond, etc.			

PUMP DATA		
PUMP TYPE (Circle One): Submersible, <u>Turbine</u> , Jet, Flowing Well, Other (Describe) _____		
POWER TYPE (Circle One): Electric, Tractor, <u>Diesel</u> , Gasoline, Butane, Other (Describe) _____		
Pump Capacity (GPM) 1400	No. of Stages 2	Setting Depth 50 FT.
PUMP TEST		
Well-yielded _____ GPM with a drawdown of _____ ft. after _____ hours of pumping		

WELL DATA		
Well Depth 120	Casing Diameter (In.) 12	Casing Length (Ft.) 80
Type of Casing PVC	Hole Depth 120	Depth to Static Water Level 41 ft.
TYPE OF COMPLETION: (Circle One or More): <u>Gravel Packed</u> , Underreamed, Telescoped, Natural Development, Open Hole, Other		
Top of Lap Pipe or Reduction in Casing		
FEET	IF TELESCOPED OR MORE THAN ONE SCREEN: USE BACK PAGE	

LOG DATA	
TYPE OF LOG RUN (Circle One): Electric, Gamma Ray, Density, Sonic, Neutron, Other (Describe) _____	
Name of Organization Running Log	


SCREEN DATA		
Diameter - Inches 12	Length - Feet 40	Slot Size - Inches 50
Screen Type PVC	Depth to Bottom - Feet 120	

GEOLOGIC DATA (Office Use Only)			
Surface Elev.	Geologic Unit	Unit Thickness	Depth to Top
Subs. SWL	Date	Analysis	Aquifer Test
Driller's Remarks			

DESCRIPTION OF FORMATIONS ENCOUNTERED	FROM	TO	FORMATIONS (Continued)
Top Soil	Top	8	<div style="font-size: 2em; font-weight: bold; opacity: 0.5;">RECEIVED</div> <div style="font-size: 1.5em; font-weight: bold; margin-top: 10px;">JUL 14 1992</div> <div style="font-weight: bold; margin-top: 10px;">Dept. of Environmental Quality Bureau of Land & Water Resources</div>
Fine Sand	8	40	
Coarse Sand	40	50	
Coarse Sand & gravel	50	120	
IF MORE SPACE IS NEEDED, USE BACK.			

If well telescopes please
sketch and show depths.

GROUND LEVEL

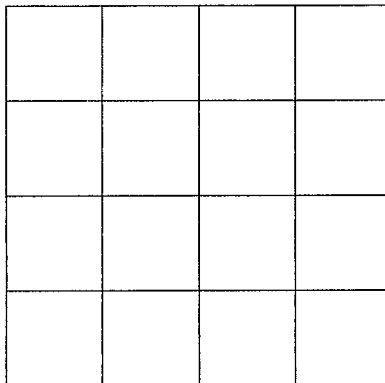

SECTION _____

Please indicate well location X.

ADDITIONAL INFORMATION

If more than one screen,
show location of each on sketch.