

SUNF. MISSISSIPPI BOARD OF WATER COMMISSIONERS

H 14

7-22-63

WATER WELL DRILLERS LOG

8/2/63 C1612
H 14

Date: July 22, 1963, Driller: Layne-Central Company County Sunflower
(Name)

(1) Owner of Land: Town of Doddsville

(Name)

Doddsville, Mississippi

(Address)

(2) Location: 1/4, 1/4, Sec. 29 T R21N R 3W

_____ miles _____ of Doddsville
(distance) (direction) (Nearest Town)

(3) Topography: flat
(Hilly) (Flat) (Level)

(4) Purpose of Well: municipal
(Domestic Irrigation
Municipal, Industrial, Other)

Information upon completion of well:

(1) Diameter 8 1/2 inches.

(2) Total Depth 1129 feet.

(3) Water Level flowing feet below top of ground. 871' - 11" 4"

(4) Cased to 201', Size 8"
22' lap


(5) Screen: Size 4", Length 40' - 10"
4" 36' blank

(6) Were any formations sealed against pollution?

yes yes, _____ no.

If YES depth of formation Cemented casing,
and has a mechanical seal and plug
Why in the bottom.

Drillers Remarks: _____

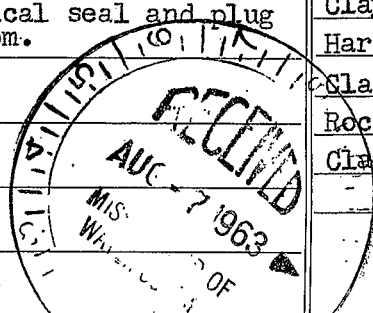

Description & Color of Materials Sand, Clay, Red Clay, Shell, etc.	Thick- ness Feet	Depth Feet.
Clay	41	41
Coarse sand	21	62
Coarse sand & pea gravel	98	160
Clay	12	172
Sand	73	245
Sand & clay strks.	46	291
White clay	67	358
Sandy clay	6	364
Hard clay	88	452
Sandy clay	23	475
Fine sand	18	493
Sand & clay strks.	37	530
Sand	75	605
Clay	7	612
Sand	36	648
Hard clay	50	698
Rock	1	699
Clay	30	729
Rock	1	730
Fine sandy clay	50	780
Fine sand	30	810
Soft sand rock	4	814
Fine sand & clay strks.	46	860
Fine sand & hard rocks strks.	29	889
Sand rock	2	891
Clay	9	901
Hard rock	1	902
Clay	4	906
Rock	1	907
Clay with small rock strks.	33	940

(over)

(Use Back Side)

Well No.

16	Clay
956	Rocks & sandy clay
17	Hard clay
970	Clay & sandy clay strks.
1025	Packed sand. Water bear-
1074	ing.
1109	Shale & clay
1129	

Sharp