

SUNF. MISSISSIPPI BOARD OF WATER COMMISSIONERS

H 15

8-20-63

WATER WELL DRILLERS LOG

Well 710.2

C1612 H15

Date August 20, 1963, Driller: Layne-Central Company County Sunflower

(Name)

(1) Owner of Land: Town of Doddsville
(Name)

Doddsville, Mississippi
(Address)

(2) Location: 1/4, 1/4, Sec. 29 T21N R3W
_____ miles _____ of Doddsville
(distance) (direction) (Nearest Town)

(3) Topography: flat
(Hilly) (Flat) (Level)

(4) Purpose of Well: municipal
(Domestic Irrigation
Municipal, Industrial, Other)

Information upon completion of well:

(1) Diameter 8x4 inches.

(2) Total Depth 1129 feet.

(3) Water Level flowing feet below top of ground.

(4) Cased to 890', Size 4"
200', Size 8"
22' 3" lap


(5) Screen: Size 4", Length 40' 10"
19' blank 4"
8x4 swage 1' 5"

(6) Were any formations sealed against pollution?

yes yes, _____

If YES depth of formation Cemented casing
and has a mechanical seal and plug
in the bottom
Why _____

Drillers Remarks: _____

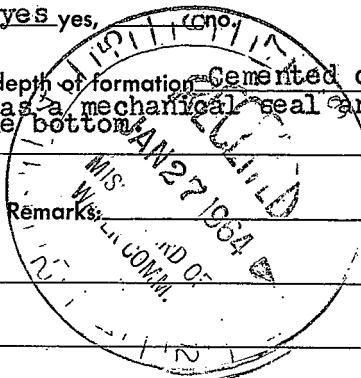

Description & Color of Materials Sand, Clay, Red Clay, Shell, etc.	Thick- ness Feet	Depth Feet
Clay	35	35
Fine sand	11	46
Coarse sand	16	62
Coarse sand and pea gravel	98	160
Clay	11	171
Sand	88	259
Sand & clay strks.	34	293
Clay	129	422
Rock	1	423
Clay	27	450
Clay, sandy clay strks.	18	468
Sandy clay	8	476
Fine sand	22	498
Sand & clay strks.	33	531
Sand	59	590
Sand & clay strks.	59	649
Hard clay	61	710
Rock	1	711
Sandy clay	16	727
Rock	1	728
Clay & sandy clay strks.	5	733
Sandy clay	15	748
Fine sand & clay strks.	75	823
Fine sand, cemented sand strks.	68	891
Rock	1	892
Clay & small rocks	35	927
Hard rock	2	929
Sandy clay	4	933
Rock	1	934
Clay	3	937
Rock	1	938

(Over)

(Use Back Side)

Well No.

Clay	6	944
Clay, cemented sand	71	1015
Clay, sandy clay strks.	52	1067
Medium sand	53	1120
Clay	9	1129