

SUNFLOWER
H 17
3-17-71

MISSISSIPPI
 BOARD OF WATER COMMISSIONERS
 416 North State Street
 Jackson, Mississippi 39201

CODED

WATER WELL DRILLERS LOG

3-17-71 19 DYER WELL & IRRIGATION SERVICE SUNFLOWER
 date well completed firm name county well located

LANDOWNER:
R. E. CONNELL JR
RULEVILLE, Miss.
 (mailing address)

WELL LOCATION:
 sec. 8 T. 21 N R. 3 ~~W~~ W
2 1/2 miles S. E. of RULEVILLE
 (distance) (direction) (nearest town)

description of formations encountered	from	to
CLAY	0	31
FINE SAND	31	42
SAND (MEDIUM)	42	47
SAND & PEA GRAIN	47	68
SAND, PEA GRAIN AND		
LARGE GRAVEL	68	103

WELL PURPOSE: IRRIGATION
 (home, irrigation, municipal, industrial)

WELL COMPLETION DATA:

(1) diameter (inches) 16"

(2) total depth (feet) 103'

(3) static water level (feet) 19' below above top of ground.

(4) casing BUR IR. 63'
 (material) (depth)

16" If telescope see back.
 (size)

(5) screen 40' 63'
 (length) (depth to top)

16" BUR IRON
 (size) (material)

(6) pump 60 3000
 (HP) (yield gpm)

ELEC.
 (type power)

(7) electric log NO
 (yes or no)

(organization running log)

(8) how well bottom plugged PLATE

CODED


MAR 22 1971

DRILLERS REMARKS:

MISS. Bd. OF
 WATER COMMISSIONERS

If well telescopes please sketch and show depths.

GROUND LEVEL

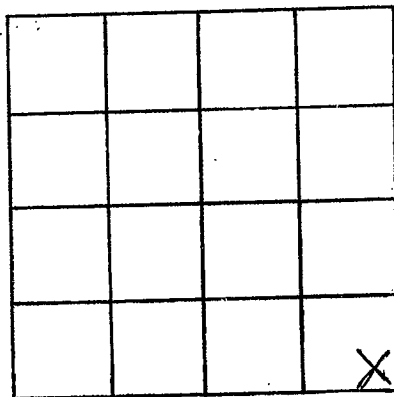

SECTION 8

Please indicate well location X.

ADDITIONAL INFORMATION

If more than one screen,
show locations of each on sketch.