

SUNF. MISSISSIPPI BOARD OF WATER COMMISSIONERS

H 19
5-16-57

WATER WELL DRILLERS LOG

CODED

Well No. 1 9/16/65
C 369

Date: May 16, , 1957 , Driller: Layne-Central Company County Sunflower

(Name)

(1) Owner of Land: Sidney Levingston
(Name)
Ruleville, Mississippi
(Address)

(2) Location: 1/4, 1/4, Sec. 11 T1R3
3 miles east of Ruleville
(distance) (direction) (Nearest Town)

(3) Topography: flat
(Hilly) (Flat) (Level)

(4) Purpose of Well: irrigation
(Domestic Irrigation
Municipal, Industrial, Other)

Description & Color of Materials Sand, Clay, Red Clay, Shell, etc.	Thick- ness Feet	Depth Feet
Blue clay	15	15
Coarse brown sand	8	23
Coarse blue sand	13	36
Coarse sand	9	45
Coarse sand & little pea rock	7	52
Sand & gravel	30	82
Sand & pea rock	30	112
Sand & gravel	10	122

Information upon completion of well:

(1) Diameter 18 x 12 inches.

(2) Total Depth 122 feet.

(3) Water Level 18'10" feet below top of ground.

(4) Cased to 68'
4' of 12" Size 18" swage

(5) Screen: Size 12" , Length 50'


(6) Were any formations sealed against pollution?
no yes, no no.

CODED

If YES depth of formation _____

Why _____

Drillers Remarks:
2750 GPM.
Engine drive.

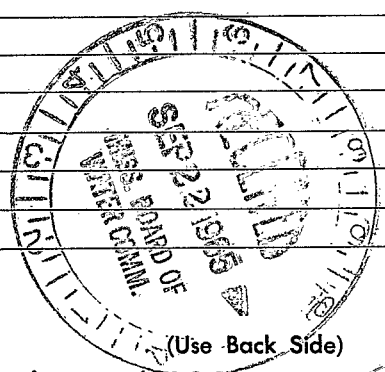

(Use Back Side)

Well

