

SUNF. MISSISSIPPI BOARD OF WATER COMMISSIONERS

H2O

5-16-57

WATER WELL DRILLING

CODED

4/16/65
Wall No. 11
C 369

Date: May 16, , 19 57 , Driller: Layne-Central Company County Sunflower

(Name)

(1) Owner of Land: Sidney Levingston
(Name)
Ruleville, Mississippi
(Address)

(2) Location: 1/4, 1/4, Sec. 11 T2R3
5 miles east of Ruleville
(distance) (direction) (Nearest Town)

(3) Topography: flat
(Hilly) (Flat) (Level)

(4) Purpose of Well: irrigation
(Domestic Irrigation
Municipal, Industrial, Other)

Description & Color of Materials Sand, Clay, Red Clay, Shell, etc.	Thick- ness Feet	Depth Feet
Clay	19	19
Fine sand	7	26
Fine blue sand	6	32
Sand & clay balls	10	42
Sand & pea rock & lignite	20	62
Sand & pea rock	10	72
Sand & pea rock	20	92
Sand & gravel	10	102
Sand & gravel	8	110

Information upon completion of well:

(1) Diameter 18x12 inches.

(2) Total Depth 110 feet.

(3) Water Level 19'7" feet below top of ground.

(4) Cased to 55' Size 18"
5' of 18" x 12" swage

(5) Screen: Size 12", Length 50'

(6) Were any formations sealed against pollution?
no yes, no no.


CODED

If YES depth of formation _____

Why _____

Drillers Remarks:
3402 GPM.

Engine drive.

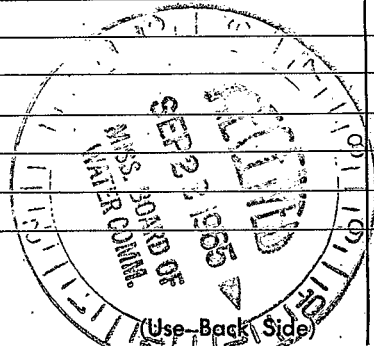

Well No.

