

SUNF. MISSISSIPPI BOARD OF WATER COMMISSIONERS

H 21
6-26-57

WATER WELL DRILLERS LOG

CODED

9/24/65
Jew
2423

Date: June 26, 1957, Driller: Layne-Central (Company County) Sunflower

(Name)

(1) Owner of Land: Mrs. F. R. Hart
(Name)

Ruleville, Mississippi
(Address)

(2) Location: 1/4, 1/4, Sec. 5 P1 R3
2 miles northeast, of Ruleville
(distance) (direction) (Nearest Town)

(3) Topography: flat
(Hilly) (Flat) (Level)

(4) Purpose of Well: irrigation
(Domestic Irrigation, Municipal, Industrial, Other)

Description & Color of Materials Sand, Clay, Red Clay, Shell, etc.	Thick- ness Feet	Depth Feet
Clay	8	8
Fine sand	8	16
Fine red sand	10	26
Fine blue sand, pea gravel and clay balls	10	36
Coarse sand, pea gravel	8	44
Coarse sand, big gravel	14	58
Coarse sand	16	74
Fine sand	11	85
Sand, gravel	15	100
Clay bottom		100

Information upon completion of well:

- (1) Diameter 12 inches.
- (2) Total Depth 100 feet.
- (3) Water Level 17' 6" feet below top of ground.
- (4) Cased to 53', Size 12"
12' of 12" blank
- (5) Screen: Size 12", Length 35'
- (6) Were any formations sealed against pollution?

no yes, no no.

If YES depth of formation _____


Why _____

Drillers Remarks: _____

1500 GPM.

Engine drive.

CODED

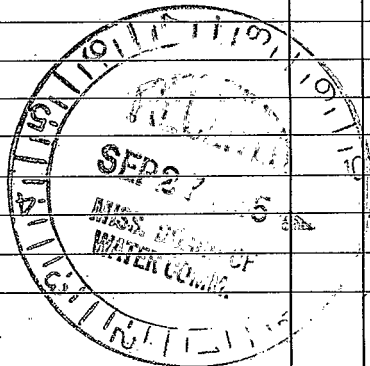

(Use Back Side)

Well No.

100

100

