

SUNFLOWER

H 23

10-19-71

MISSISSIPPI
 BOARD OF WATER COMMISSIONERS
 416 North State Street
 Jackson, Mississippi 39201

CODED

WATER WELL DRILLERS LOG

BUTANE GAS CO. OF GREENWOOD

Sunflower

10/19/71
date well completed

firm name

county well located

LANDOWNER:

Mrs. Thelma Yount

Doddsville

(mailing address)

description of formations encountered

from

to

Clay

0 30

Sand + Gravel

30 180

Shale + Clay

180 500

Sand

500 555

WELL LOCATION:

sec. 24 T 21 N
S

R. 3 E
W

3 miles NE of Doddsville
(distance) (direction) (nearest town)

WELL PURPOSE: Home
(home, irrigation, municipal, industrial)

WELL COMPLETION DATA:

- (1) diameter (inches) 4 1/2
- (2) total depth (feet) 545
- (3) static water level (feet) 25 below top of ground.
- (4) casing Steel, 525 (material) (depth)
4 1/2" if telescope see back. (size)
- (5) screen 20, 525 (length) (depth to top)
2" Stainless Steel (size) (material)
- (6) pump 1, 25 (HP) (yield gpm)
E.I.C. (type power)
- (7) electric log NO (yes or no)

CODED

(organization running log)

NOV 9 - 1971

(8) how well bottom plugged
Lead Plug

MISS. BD. OF
WATER COMM.

DRILLERS REMARKS:


If well telescopes please sketch and show depths.

GROUND LEVEL

105' - 4" CASING →

4.20' - 2" CASING →

70' - Screen →

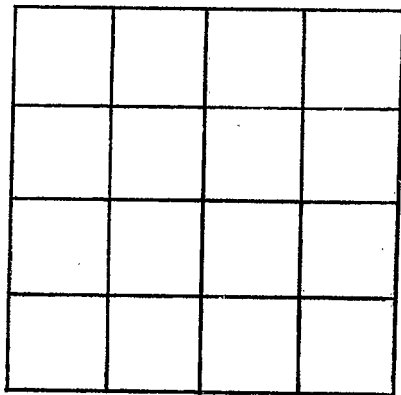

SECTION 24

Please indicate well location X.

ADDITIONAL INFORMATION

If more than one screen,
show locations of each on sketch.