

SUNFLOWER
A27
3-6-75

MISSISSIPPI
 BOARD OF WATER COMMISSIONERS
 416 North State Street
 Jackson, Mississippi 39201

CODED

WATER WELL DRILLERS LOG

3-6-75 19
 date well completed

ENTANE GAS CO. OF GREENWOOD
 firm name

Sunflower
 county well located

LANDOWNER:
MAURY M. Intyre
Doddsville
 (mailing address)

description of formations encountered	from	to
CLAY	0	30
CLAY SAND + GRAVEL	30	40
SAND + GRAVEL	40	110

WELL LOCATION:
 sec. 34 T. 28 N R. 3 E 15th
 & W
2 1/2 miles SE of Doddsville
 (distance) (direction) (nearest town)

WELL PURPOSE: FR
 (home, irrigation, municipal, industrial)

CODED

- WELL COMPLETION DATA:**
- (1) diameter (inches) 16"
 - (2) total depth (feet) 110'
 - (3) static water level (feet) 17' below top of ground.
 - (4) casing Steel, 70'
 (material) (depth)
16" If telescope see back.
 (size)
 - (5) screen 40', 70'
 (length) (depth to top)
16", Steel
 (size) (material)
 - (6) pump 600, 3000
 (HP) (yield gpm)
Diesel
 (type power)
 - (7) electric log no
 (yes or no)
- (organization running log)
- (8) how well bottom plugged Steel plate


DRILLERS REMARKS:

RECORDED
INDEXED
 MAR 24 1975

MISS. BD. OF WATER COMMISSIONERS

If well telescopes please sketch and show depths.

GROUND LEVEL

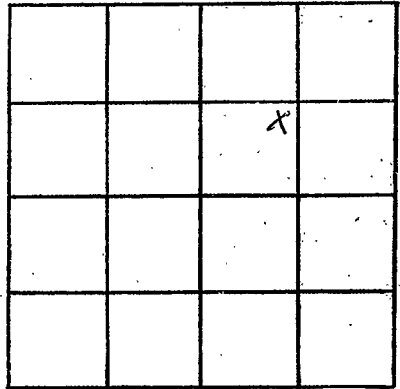

SECTION 34

Please indicate well location X.

ADDITIONAL INFORMATION

If more than one screen, show locations of each on sketch.