


SUNFLOWER
H 28
4-8-75

MISSISSIPPI
 BOARD OF WATER COMMISSIONERS
 416 North State Street
 Jackson, Mississippi 39201

CODED


WATER WELL DRILLERS LOG

4-8-75 19 BUTANE GAS CO. OF GREENWOOD Sunflower
 date well completed firm name county well located

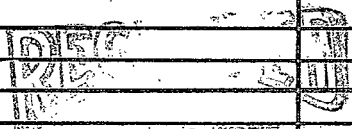LANDOWNER:	description of formations encountered	from	to
<u>Mary McIntyre</u> <u>Doddsville</u> (mailing address)			
WELL LOCATION:			
sec <u>35</u> T <u>21</u> N R <u>3</u> E W			
<u>2 3/4</u> miles <u>SE</u> of <u>Doddsville</u> (distance) (direction) (nearest town)			
WELL PURPOSE: <u>FRR</u> (home, irrigation, municipal, industrial)			
WELL COMPLETION DATA:			
(1) diameter (inches) <u>16</u>			
(2) total depth (feet) <u>100</u>			
(3) static water level (feet) <u>16</u> <small>below above</small> top of ground.			
(4) casing <u>Steel</u> <u>60</u> (material) (depth)			
<u>16</u> " (size) if telescope see back.			
(5) screen <u>40</u> <u>60</u> (length) (depth to top)			
<u>16</u> " (size) <u>Steel</u> (material)			
(6) pump <u>65</u> <u>7000</u> (HP) (yield gpm)			
<u>Diesel</u> (type power)			
(7) electric log <u>No</u> (yes or no)			
(organization running log)			
(8) how well bottom plugged <u>Steel Plate</u>			
DRILLERS REMARKS:			
 APR 16 1975 MISS. BD. OF WATER COMMISSIONERS			

If well telescopes please sketch and show depths.

GROUND LEVEL

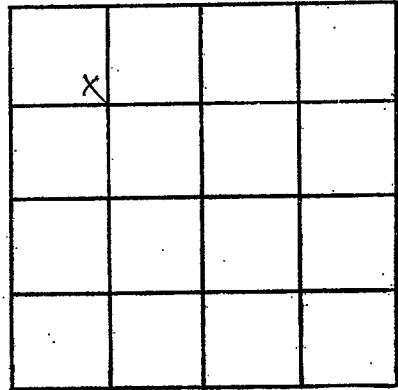

SECTION 34

Please indicate well location X.

ADDITIONAL INFORMATION

If more than one screen, show locations of each on sketch.