

SUNFLOWER
H 29
4-11-75

MISSISSIPPI
 BOARD OF WATER COMMISSIONERS
 416 North State Street
 Jackson, Mississippi 39201

CODED

WATER WELL DRILLERS LOG

4-11-75
 date well completed

BUTANE GAS CO. OF GREENWOOD
 firm name

Sunflower
 county well located

LANDOWNER:	description of formations encountered	from	to
MAURY McINTYRE Doddsville (mailing address)			
WELL LOCATION:			
sec. 35 T. 21 N. R. 3 E. 3 miles SE of Doddsville (distance) (direction) (nearest town)			
WELL PURPOSE: IRR (home, irrigation, municipal, industrial)			
WELL COMPLETION DATA:			
(1) diameter (inches) 16"			
(2) total depth (feet) 94			
(3) static water level (feet) 16 below above top of ground.			
(4) casing Steel 54 (material) (depth) 16" (size) If telescope see back.			
(5) screen 40 54 (length) (depth to top) 16" Steel (size) (material)			
(6) pump 65 3000 (HP) (yield gpm) Diesel (type power)			
(7) electric log No (yes or no)			
(organization running log)			
(8) how well bottom plugged Steel Plate			
DRILLERS REMARKS:			


CODED

RECEIVED
 APR 16 1975

MISS. BD. OF WATER COMM.

If well telescopes please sketch and show depths.

GROUND LEVEL

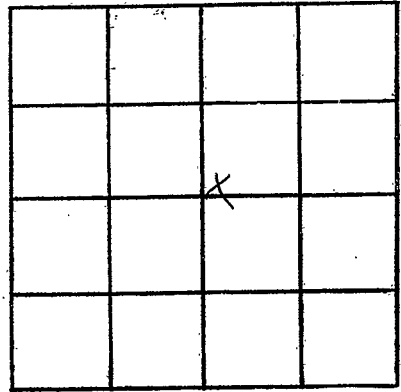

SECTION 315

Please indicate well location X.

ADDITIONAL INFORMATION

If more than one screen, show locations of each on sketch.