

11094 —

MISSISSIPPI
BOARD OF WATER COMMISSIONERS
416 North State Street
Jackson, Mississippi 39201

3/2/67
JMC 2380

Sunflower
H 31
2-67

WATER WELL DRILLERS LOG

February 21, 1967 Layne-Central Company Sunflower
date well completed firm name county well located

LANDOWNER: Mrs. Ida Chambliss

description of formations encountered	from	to
Clay	0	18
Fine sand	18	27
Coarse sand	27	44
Coarse sand, gravel	44	103
Cemented gravel & sand		
came out in big boulders		103


Adamsville, Alabama
(mailing address)

WELL LOCATION:
sec. 11 T 21 N R 3 E S 1 W
4 miles southeast of Ruleville
(distance) (direction) (nearest town)

WELL PURPOSE: irrigation
(home, irrigation, municipal, industrial)


- WELL COMPLETION DATA:
- (1) diameter (inches) 16
 - (2) total depth (feet) 104
 - (3) static water level (feet) 20' 5" above top of ground
 - (4) casing steel, 54' (material), (depth)
16" (size) If telescope see back.
 - (5) screen 50', 54' (length), (depth to top)
16" (size), Armco (material)
 - (6) pump 50 HP, 2400 (yield gpm)
elec. (type power)
 - (7) electric log no (yes or no)
(organization running log)
 - (8) how well bottom plugged plate
No other information available this date.

DRILLERS REMARKS:

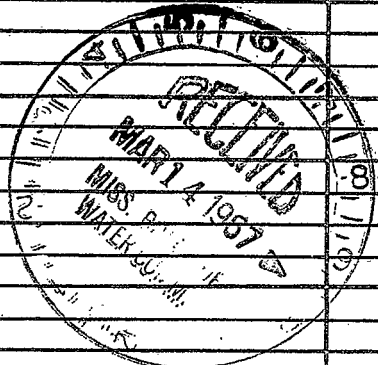

If well telescopes please sketch and show depths.

GROUND LEVEL

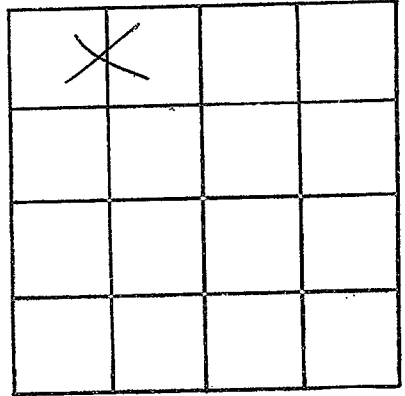

SECTION 11

Please indicate well location X.

ADDITIONAL INFORMATION

If more than one screen, show locations of each on sketch.