

SUNFLOWER
H 35
2-3-77

MISSISSIPPI
BOARD OF WATER COMMISSIONERS
416 North State Street
Jackson, Mississippi 39201

CODED

WATER WELL DRILLERS LOG

DYER-SULLIVAN, INC.

SUNFLOWER

2-3
date well completed

19 77
firm name

county well located

LANDOWNER: Billy Barlow

R.R. 1

Ruleville, Miss.

(mailing address)

WELL LOCATION:

sec. 36 T. 21 N R. 3 E
& SE W
5 miles SE of Ruleville
(distance) (direction) (nearest town)

WELL PURPOSE: ILL.
(home, irrigation, municipal, industrial)

WELL COMPLETION DATA:

- (1) diameter (inches) 16"
- (2) total depth (feet) 117'
- (3) static water level (feet) 16 below above top of ground.
- (4) casing Steel, 77'
(material) (depth)
16" if telescope see back.
(size)
- (5) screen 40', 77'
(length) (depth to top)
16", Steel
(size) (material)
- (6) pump 40, 1800
(HP) (yield gpm)
Diesel
(type power)
- (7) electric log NO
(yes or no)

(organization running log)

(8) how well bottom plugged PIATE

description of formations encountered

from to

CLAY	0	11
FINE SAND & CLAY	11	29
FINE SAND	29	31
COURSE SAND	31	46
COURSE SAND & GRAVEL	46	117

CODED


DRILLERS REMARKS:

RECEIVED
DYE SULLIVAN
MAR 18 1977

MISS. Bd. OF WATER COMM.

If well telescopes please sketch and show depths.

GROUND LEVEL

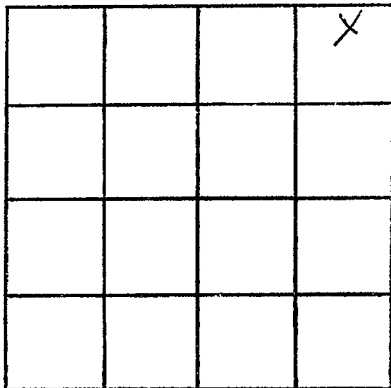

SECTION _____

Please indicate well location X.

ADDITIONAL INFORMATION

If more than one screen,
show locations of each on sketch.