


SUNFLOWER
 H  36
 4-30-77

MISSISSIPPI
 BOARD OF WATER COMMISSIONERS
 416 North State Street
 Jackson, Mississippi 39201
 WATER WELL DRILLERS LOG

CODED

April 30 19 77 Layne Central Co. Sunflower
 date well completed firm name county well located

LANDOWNER:	description of formations encountered	from	to
Milburn Farms			
Ruleville, MS	Clay	0	20
(mailing address)	Med. Coarse Sand & Pea Gr	20	23
WELL LOCATION:	Coarse Sand & Gravel	23	33
sec. 2 T 22 N 3W	Coarse Sand & Gravel	33	43
R 1/2 Ex W	Coarse Sand & Gravel	43	53
8 miles East of Ruleville	Coarse Sand & Gravel	53	63
(distance) (direction) (nearest town)	Gravel & Coarse Sand	63	73
WELL PURPOSE: Irrigation	Gravel & Coarse Sand	73	83
(home, irrigation, municipal, industrial)	Gravel & Coarse Sand	83	93
WELL COMPLETION DATA:	Gravel & Coarse Sand	93	103
(1) diameter (inches) 16"			
(2) total depth (feet) 103			
(3) static water level (feet) 26 below top of ground.			
(4) casing Steel 52' (material), (depth)			
16" (size) if telescope see back.			
(5) screen 50' (length), 53' (depth to top)			
16" (size), Stainless Steel (material)			
(6) pump 40 (HP), 2000 (yield gpm)			
diesel (type power)			
(7) electric log No (yes or no)			
(organization running log)			
(8) how well bottom plugged Steel Pl.			
DRILLERS REMARKS:			


CODED

RECEIVED
 JUN 23 1977

MISS. BD. OF WATER COMMISSIONERS

If well telescopes please sketch and show depths.

GROUND LEVEL

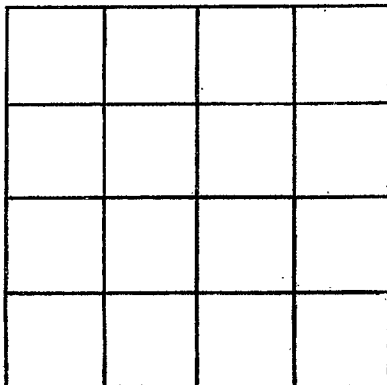

SECTION _____

Please indicate well location X.

ADDITIONAL INFORMATION

If more than one screen, show locations of each on sketch.