

Gw 5601  
 NW/4W, Sec. 35  
 Elev. 126

**SUNFLOWER**  
 CT.-0791  
 H 39  
 3-12-78

MISSISSIPPI  
 BOARD OF WATER COMMISSIONERS  
 416 North State Street  
 Jackson, Mississippi 39201  
**WATER WELL DRILLERS LOG**

**CODED**

3-12 date well completed 1978 LAYNE CENTRAL CO. firm name SUNFLOWER county well located

**LANDOWNER:**  
 H. C. Eastland  
 Doddsville, MS

description of formations encountered	from to	
	feet	feet
Clay		
Coarse Sand	0	50
Fine Sand	50	70
Coarse Sand & Gr.	70	80
Fine Sand	80	125

(mailing address)

**WELL LOCATION:**  
 sec. 33 T 21 N R 3 W  
 1 miles SE of Doddsville  
 (distance) (direction) (nearest town)

**WELL PURPOSE:** Irrigation  
 (home, irrigation, municipal, industrial)

**WELL COMPLETION DATA:**

- (1) diameter (inches) 16"
- (2) total depth (feet) 125'
- (3) static water level (feet) 24 below top of ground.
- (4) casing Steel, 85' (material) (depth)  
 16" (size) if telescope see back.
- (5) screen 40' 85' (length) (depth to top)  
 16" St. Steel (size) (material)
- (6) pump 40 2000 (HP) (yield gpm)  
 Diesel (type power)
- (7) electric log (yes or no)
- (8) how well bottom plugged St. Plate (organization running log)


**CODED**

**RECEIVED**  
 OCT 5 1978

**DRILLERS REMARKS:**

If well telescopes please sketch and show depths.

GROUND LEVEL

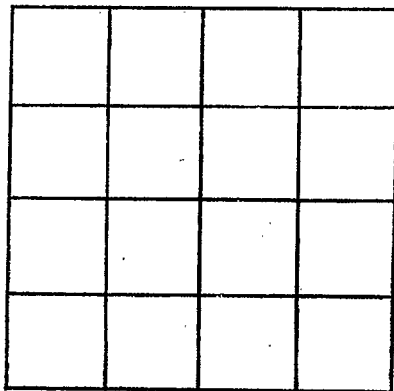

SECTION \_\_\_\_\_

Please indicate well location X.

ADDITIONAL INFORMATION

A series of horizontal lines for writing additional information, starting below the 'ADDITIONAL INFORMATION' header and extending to the bottom of the page.

If more than one screen, show locations of each on sketch.