

SUNFLOWER
 CL-0791
 H 41
 3-12-78

MISSISSIPPI
 BOARD OF WATER COMMISSIONERS
 416 North State Street
 Jackson, Mississippi 39201

CODED

WATER WELL DRILLERS LOG

3-12 1978 LAYNE CENTRAL CO. SUNFLOWER
 date well completed firm name county well located

LANDOWNER: H.C. Eastland
 Doddsville, MS

description of formations encountered	from	to
Clay	0	50
Coarse Sand	0	50

(mailing address)

WELL LOCATION:

sec. 33 T 21 N R. 3 W
 1 miles SE of Doddsville
 (distance) (direction) (nearest town)

WELL PURPOSE: Irrigation
 (home, irrigation, municipal, industrial)

WELL COMPLETION DATA:

(1) diameter (inches) 16"
 (2) total depth (feet) 125
 (3) static water level (feet) 24 below top of ground.

(4) casing Steel, 85' (material) (depth)
 16" (size) if telescope see back.

(5) screen 40 85 (length) (depth to top)
 16" (size) (material)

(6) pump 49' 85 (HP) (yield gpm)
 diesel (type power)

(7) electric log no (yes or no)
 (organization running log)

(8) how well bottom plugged St. Plate


DRILLERS REMARKS:

CODED

RECEIVED
 OCT 5 1978

If well telescopes please sketch and show depths.

GROUND LEVEL

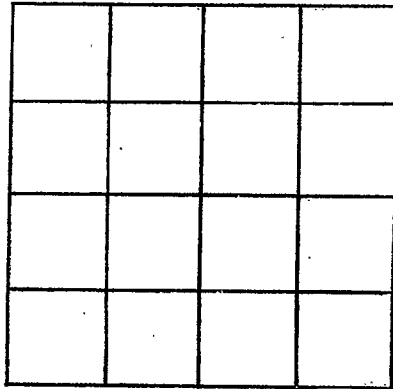

SECTION _____

Please indicate well location X.

ADDITIONAL INFORMATION

A series of horizontal lines for recording additional information, starting below the 'ADDITIONAL INFORMATION' header and extending to the bottom of the page.

If more than one screen, show locations of each on sketch.