

SUNFLOWER
H 43
12/8/78

MISSISSIPPI
BOARD OF WATER COMMISSIONERS
416 North State Street
Jackson, Mississippi 39201

CODED

WATER WELL DRILLERS LOG

Sunflower

12-8-1978 date well completed 1978 Larry's Well Pump Co. firm name Sunflower county well located

LANDOWNER: Dale Davis
RT-1 Paragould
Arkansas (mailing address)

description of formations encountered	from	to
clay	0	18
med sand	18	23
med to coarse sand	23	40
coarse sand & gravel	40	50
coarse sand & gravel - Rock	50	60
coarse sand & gravel	60	110

WELL LOCATION:
sec. 1 T 27 N S R 3 E W
4 E 1 S miles E 1 S of Rulaville
(distance) (direction) (nearest town)

WELL PURPOSE: Irrigation
(home, irrigation, municipal, industrial)

- WELL COMPLETION DATA:
- (1) diameter (inches) 16"
 - (2) total depth (feet) 110'
 - (3) static water level (feet) 22' below top of ground.
 - (4) casing steel, 70' (material) (depth)
(size) If telescope see back.
 - (5) screen 40' 70' (length) (depth to top)
16" steel (size) (material)
 - (6) pump 60 3000 (HP) (yield gpm)
D (type power)
 - (7) electric log no (yes or no)
(organization running log)
 - (8) how well bottom plugged steel plate

CODED


RECEIVED
JAN 5 1978

DRILLERS REMARKS:

MISS. BD. OF WATER COMM

If well telescopes please sketch and show depths.

GROUND LEVEL

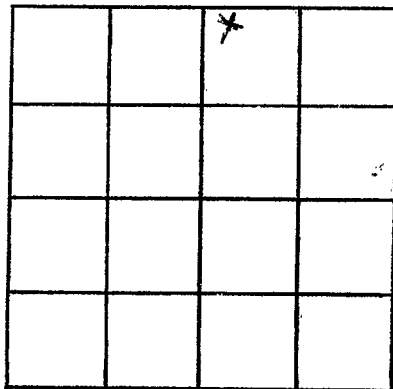

SECTION 1

Please indicate well location X.

ADDITIONAL INFORMATION

If more than one screen,
show locations of each on sketch.