

SUNFLOWER
 H 45
 3-28-79

MISSISSIPPI
 BOARD OF WATER COMMISSIONERS
 416 North State Street
 Jackson, Mississippi 39201

CODED

WATER WELL DRILLERS LOG
 BUTANE GAS COMPANY

3-13-79 19 date well completed
 OF GREENWOOD county well located
 Sunflower

LANDOWNER:
 Sturdivant + Biskop
 Glenora
 (mailing address)

description of formations encountered	from	to
CLAY	0	38
FINE SAND	38	56
COARSE SAND	56	68
SAND + Pea GRAVEL	68	80
SAND + GRAVEL	80	110

WELL LOCATION:
 sec. 7 T. 24 N R. 3 E W
 1 miles S of Ruleville
 (distance) (direction) (nearest town)

WELL PURPOSE: FRR
 (home, irrigation, municipal, industrial)

WELL COMPLETION DATA:

(1) diameter (inches) 16"

(2) total depth (feet) 110

(3) static water level (feet) 20 below top of ground.

(4) casing Steel 70
 (material) (depth)
 16" if telescope see back.
 (size)

(5) screen 40 70
 (length) (depth to top)
 16" Steel
 (size) (material)

(6) pump 60 2800
 (HP) (yield gpm)
 Diesel
 (type power)

(7) electric log No
 (yes or no)

(organization running log)

(8) how well bottom plugged Steel Plate

DRILLERS REMARKS:

CODED


Miss. Board of Water Comm.

MAR 27 1979

RECEIVED

If well telescopes please sketch and show depths.

GROUND LEVEL

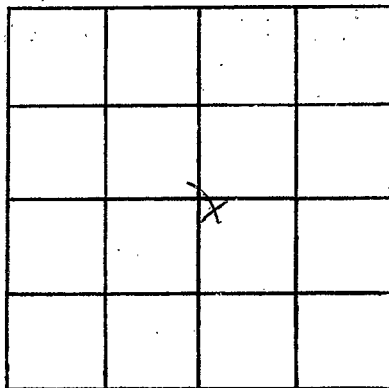

SECTION 7

Please indicate well location X.

ADDITIONAL INFORMATION

If more than one screen,
show locations of each on sketch.