

SUNFLOWER  
H 47  
5-10-79

MISSISSIPPI  
BOARD OF WATER COMMISSIONERS  
416 North State Street  
Jackson, Mississippi 39201

CODED

WATER WELL DRILLERS LOG

BUTANE GAS COMPANY  
OF GREENWOOD

Sunflower  
county well located

5-10-79 19  
date well completed

LANDOWNER:  
Mary McIntyre  
Doddsville  
(mailing address)

description of formations encountered	from	to
Clay	0	20
Fine sand	20	45
Sand + Pea Gravel	45	90
Sand + Gravel	90	107

WELL LOCATION:  
sec. 33 T. 24 N R. 3 E  
1 miles SE of Doddsville  
(distance) (direction) (nearest town)

WELL PURPOSE: IRR  
(home, irrigation, municipal, industrial)

- WELL COMPLETION DATA:
- (1) diameter (inches) 16"
  - (2) total depth (feet) 107
  - (3) static water level (feet) 20 below top of ground.
  - (4) casing Steel, 67' (material), (depth)  
16" (size) if telescope see back.
  - (5) screen 40' 67' (length), (depth to top)  
16" Steel (size), (material)
  - (6) pump 60 2800 (HP), (yield gpm)  
Diesel (type power)
  - (7) electric log NO (yes or no)
  - (organization running log)
  - (8) how well bottom plugged  
Steel plate

DRILLERS REMARKS:


Miss. Board of Water Comm.

11114 - 8 1979

RECEIVED

If well telescopes please  
sketch and show depths.

GROUND LEVEL

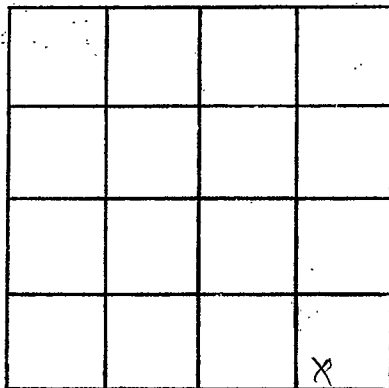

SECTION 33

Please indicate well location X.

ADDITIONAL INFORMATION

If more than one screen,  
show locations of each on sketch.