

SUNFLOWER

H48

6-14-79

MISSISSIPPI BOARD OF WATER COMMISSIONERS 416 North State Street Jackson, Mississippi 39201

CODED

WATER WELL DRILLERS LOG

6-14

date well completed

1979 Larry Wellt Pumping Sunflower County

firm name

county well located

LANDOWNER: Doyle E. Ponder

Rt 1 Box 104

Rulerille miss. (mailing address)

WELL LOCATION:

sec. 1 T 21 N R 3 E S 3 W

4 1/2 E miles 1 1/2 S of Rulerille (distance) (direction) (nearest town)

WELL PURPOSE: (home, irrigation, municipal, industrial)

WELL COMPLETION DATA:

- (1) diameter (inches) 12"
(2) total depth (feet) 115'
(3) static water level (feet) 19 below top of ground.
(4) casing steel 75' (material) (depth)
(5) screen 40 75' (length) (depth to top) 12" steel (size) (material)
(6) pump 40 2000 (HP) (yield gpm)
D (type power)
(7) electric log (yes or no)

(organization running log)

(8) how well bottom plugged steel plate

DRILLERS REMARKS:

Description of formations encountered

from to

Table with 3 columns: Description of formations encountered, from, to. Rows include clay, med ft fine sand, med coarse sand, coarse sand gravel, clay, coarse sand gravel.

CODED


Miss. Board of Water Comm.

JUL 5 1979

RECEIVED

If well telescopes please sketch and show depths.

GROUND LEVEL

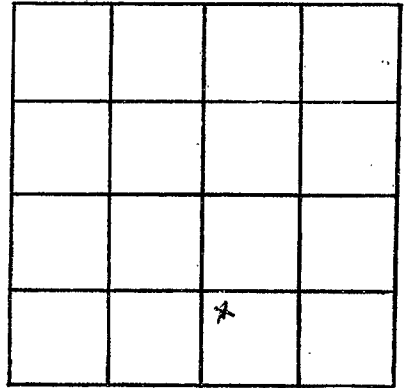

SECTION 1

Please indicate well location X.

ADDITIONAL INFORMATION

If more than one screen,  
show locations of each on sketch.