

SUNFLOWER
H 49
6/15/79

MISSISSIPPI
BOARD OF WATER COMMISSIONERS
416 North State Street
Jackson, Mississippi 39201

WATER WELL DRILLERS LOG

6-15
date well completed

1979

Larry Well & Pump & Sunlines
firm name

county well located

LANDOWNER: Doyle E Davidson
R+1 Box 104
Rulerville Miss
(mailing address)

description of formations encountered	from	to
clay	0	30
fine sand	30	45
med sand	45	60
med & coarse sand	60	75
coarse sand & gravel	75	114

WELL LOCATION:
sec. 1 T 21 N R 3 E
S W
4 E miles 1.5 of Rulerville
(distance) (direction) (nearest town)

WELL PURPOSE:
(home, irrigation, municipal, industrial)

- WELL COMPLETION DATA:
- (1) diameter (inches) 12"
 - (2) total depth (feet) 114'
 - (3) static water level (feet) 20' below top of ground.
 - (4) casing steel 74' (material) (depth)
 - (5) screen 40' 74' (length) (depth to top)
12" steel (size) (material)
 - (6) pump 30 2000 (HP) (yield gpm)
 - (7) electric log (yes or no)
 - (8) how well bottom plugged steel & dirt

DRILLERS REMARKS:


Miss. Board of Water Comm.

JUL 19 1979

RECEIVED

If well telescopes please sketch and show depths.

GROUND LEVEL

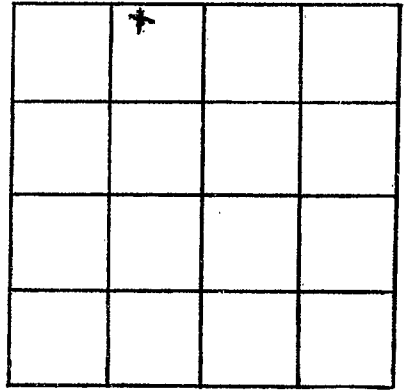

SECTION 1

Please indicate well location X.

ADDITIONAL INFORMATION

If more than one screen, show locations of each on sketch.