

SUNFLOWER  
H 50  
8-1-19

MISSISSIPPI  
BOARD OF WATER COMMISSIONERS  
416 North State Street  
Jackson, Mississippi 39201

CODED

WATER WELL DRILLERS LOG

8-1 1979 Larry Well Pumpers Sunflower  
date well completed firm name county well located

LANDOWNER: Stan Speckman

description of formations encountered

from

to

Doddsville Miss

clay

0

57

red sand

57

95

coarse sand gravel

95

112

(mailing address)

WELL LOCATION:

sec 28 T 21 N R 3 E  
S W  
1/2 miles East of Doddsville  
(distance) (direction) (nearest town)

CODED

WELL PURPOSE: Wash Pond  
(home, irrigation, municipal, industrial)

WELL COMPLETION DATA:

- (1) diameter (inches) 16"
- (2) total depth (feet) 112
- (3) static water level (feet) 20 below top of ground.
- (4) casing steel, 72' (material) (depth)
- (size) if telescope see back.
- (5) screen 40, 72' (length) (depth to top)
- 16" steel (size) (material)
- (6) pump 60, 3000 (HP) (yield gpm)
- Electric (type power)
- (7) electric log (yes or no)

(organization running log)

Miss. Board of Water Comm.

(8) how well bottom plugged


AUG 21 1979

DRILLERS REMARKS:

RECEIVED

If well telescopes please sketch and show depths.

GROUND LEVEL

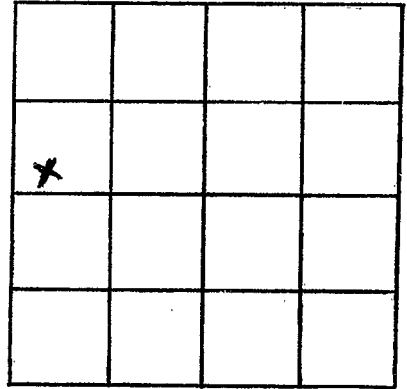

SECTION 28

Please indicate well location X.

ADDITIONAL INFORMATION

If more than one screen,  
show locations of each on sketch.