

SUNFLOWER
 CL-1129 H57
4-5-79

MISSISSIPPI
 BOARD OF WATER COMMISSIONERS
 416 North State Street
 Jackson, Mississippi 39201

CODED

WATER WELL DRILLERS LOG

April 5, 19 79 Layne Central Company Sunflower
 date well completed firm name county well located

LANDOWNER:	description of formations encountered	from	to
Lake Linsey			
Doddsville, MS	Fine Sand	28	66
(mailing address)	C. Sand & Gravel	66	98
	C. Sand & Big Gravel	98	122

WELL LOCATION:
 sec. 35 T 21 N R 3 E
 ? 3 miles NE of Doddsville
 (distance) (direction) (nearest town)

WELL PURPOSE: irrigation
 (home, irrigation, municipal, industrial)

WELL COMPLETION DATA:

(1) diameter (inches) 16"

(2) total depth (feet) 122'

(3) static water level (feet) 19 below above top of ground.

(4) casing Steel, 72'
 (material), (depth)
16"
 (size) if telescope see back.

(5) screen 50', 72'
 (length), (depth to top)
16" St St
 (size), (material)

(6) pump 60 2500
 (HP), (yield gpm)
Diesel
 (type power)

(7) electric log No
 (yes or no)

(organization running log)

(8) how well bottom plugged St Plate

CODED

Miss. Board of Water Comm.


SEP 12 1979

DRILLERS REMARKS:

RECEIVED

If well telescopes please sketch and show depths.

GROUND LEVEL

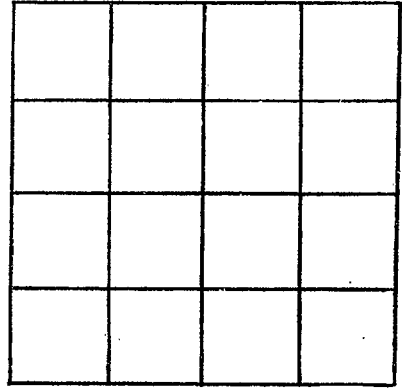

SECTION _____

Please indicate well location X.

ADDITIONAL INFORMATION

A series of horizontal lines for recording additional information, starting below the 'ADDITIONAL INFORMATION' header and extending to the bottom of the page.

If more than one screen, show locations of each on sketch.