

SUNFLOWER

Bolivar

CL-1139 H54

4-7-79

MISSISSIPPI BOARD OF WATER COMMISSIONERS
416 North State Street
Jackson, Mississippi 39201

WATER WELL DRILLERS LOG

Sunflower Bolivar

April 7, 1979 Layne Central Company

date well completed

firm name

county well located

LANDOWNER:	description of formations encountered	from	to
M. L. Stephenson			
Doddsville, MS (mailing address)	C. Red Sand	17	25
WELL LOCATION:	Fine Sand	25	36
sec. 25 T-21 N R-3 E S W	C. Sand	36	45
3 miles NE of Doddsville (distance) (direction) (nearest town)	C. Sand & P. Gravel	45	57
WELL PURPOSE: irrigation (home, irrigation, municipal, industrial)	C. Sand & Gravel	57	89
WELL COMPLETION DATA:	C. Sand & Big Gravel	89	114
(1) diameter (inches) 16"			
(2) total depth (feet) 114'			
(3) static water level (feet) 22' below top of ground.			
(4) casing Steel 64' (material) (depth) 16" (size) If telescope see back.			
(5) screen 50' 64' (length) (depth to top) 116" St St (size) (material)			
(6) pump 60 2500 (HP) (yield gpm) Diesel (type power)			
(7) electric log NO (yes or no)			
(organization running log)			
(8) how well bottom plugged St Plate			
DRILLERS REMARKS:			


Miss. Board of Water Comm.

SEP 12 1979

RECEIVED

If well telescopes please
sketch and show depths.

GROUND LEVEL

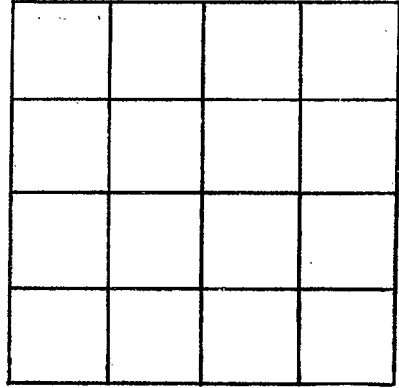

SECTION _____

Please indicate well location X.

ADDITIONAL INFORMATION

If more than one screen,
show locations of each on sketch.