

SUNFLOWER
H 55
6-11-79

MISSISSIPPI
BOARD OF WATER COMMISSIONERS
416 North State Street
Jackson, Mississippi 39201

CODED

WATER WELL DRILLERS LOG

6/8/79 19 DYER WELL + IRR SUNFLOWER
date well completed : firm name county well located

LANDOWNER:
LAKE LINDSEY FARMS
DODDSVILLE
(mailing address)

description of formations encountered	from	to
CLAY	0	20
FINE SAND	20	25
SAND	25	40
SAND + GRAVEL	40	100

WELL LOCATION:
sec. 29 T. 21 N. R. 3 E
S W
2 miles E of DODDSVILLE
(distance) (direction) (nearest town)

WELL PURPOSE:
(home, irrigation, municipal, industrial)

CODED

- WELL COMPLETION DATA:
- (1) diameter (inches) 12
 - (2) total depth (feet) 100
 - (3) static water level (feet) 19 below above top of ground.
 - (4) casing STEEL, 60 (material) (depth)
 - 12 If telescope see back. (size)
 - (5) screen 40', 60 (length) (depth to top)
 - 12, STEEL (size) (material)
 - (6) pump 40 1500-1800 (HP) (yield gpm)
 - DIESEL (type power)
 - (7) electric log NO (yes or no)

(organization running log)
(8) how well bottom plugged PLATE

DRILLERS REMARKS:


DEPT. OF NATURAL RESOURCES
BUREAU OF LAND & WATER RESOURCES

OCT 20 1979

RECEIVED

If well telescopes please sketch and show depths.

GROUND LEVEL

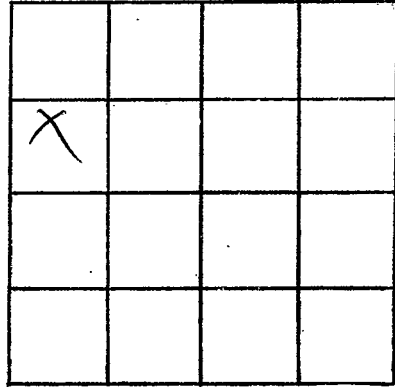

SECTION 29

Please indicate well location X.

ADDITIONAL INFORMATION

Lined area for additional information.

If more than one screen, show locations of each on sketch.