

SUNFLOWER
H 59
6/5/79

MISSISSIPPI
BOARD OF WATER COMMISSIONERS
416 North State Street
Jackson, Mississippi 39201

CODED

WATER WELL DRILLERS LOG

6/5 1979 DYER WELL SUNFLOWER
date well completed firm name county well located

LANDOWNER:
PAUL NICHOLS
DODDSVILLE
(mailing address)

description of formations encountered	from	to
CLAY	0	45
SAND	45	85
SAND & GRAVEL	85	112

WELL LOCATION:
sec. 17 T. 21 N. R. 3 E
S W
2 miles E of DODDSVILLE
(distance) (direction) (nearest town)

WELL PURPOSE:
(home, irrigation, municipal, industrial)

- WELL COMPLETION DATA:
- (1) diameter (inches) 16
 - (2) total depth (feet) 112
 - (3) static water level (feet) 19 below above top of ground.
 - (4) casing STEEL 72 (material) (depth) 16 if telescope see back. (size)
 - (5) screen 40' 72 (length) (depth to top) 16 STEEL (size) (material)
 - (6) pump 60 3000 (HP) (yield gpm) ELECTRIC (type power)
 - (7) electric log NO (yes or no)
 - (organization running log)
 - (8) how well bottom plugged PLATE

CODED

DEPT. OF NATURAL RESOURCES
BUREAU OF LAND & WATER RESOURCES


OCT 29 1979

RECEIVED

DRILLERS REMARKS:

If well telescopes please sketch and show depths.

GROUND LEVEL

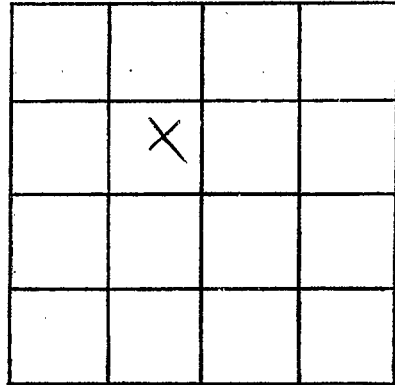

SECTION 17

Please indicate well location X.

ADDITIONAL INFORMATION

A series of horizontal lines for writing additional information, starting below the 'ADDITIONAL INFORMATION' header and extending to the bottom of the page.

If more than one screen, show locations of each on sketch.