

Sunflower

H-65

04/21/80

4-21-80

date well completed

MISSISSIPPI BOARD OF WATER COMMISSIONERS  
416 North State Street  
Jackson, Mississippi 39201

CODED

WATER WELL DRILLERS LOG  
BUTANE GAS COMPANY

OF GREENWOOD

Sunflower county well located

LANDOWNER:

SHelton Farms

(mailing address)

description of formations encountered

from

to

Clay

0 40

SAND

40 70

SAND & GRAVEL

70 113

WELL LOCATION:

sec. 17 T 21 N R 3 E  
3 miles SE of ROUEILLE  
(distance) (direction) (nearest town)

CODED

WELL PURPOSE:

IRR (home, irrigation, municipal, industrial)

WELL COMPLETION DATA:

- (1) diameter (inches) 16
- (2) total depth (feet) 113
- (3) static water level (feet) 20 below top of ground.
- (4) casing Steel, 73 (material) (depth)  
16 (size) If telescope see back.
- (5) screen 40, 73 (length) (depth to top)  
16" Steel (size) (material)
- (6) pump 60, 2500 (HP) (yield gpm)  
E.L.C. (type power)
- (7) electric log No (yes or no)

(organization running log)

(8) how well bottom plugged Steel Plate

DRILLERS REMARKS:


DEPT. OF NATURAL RESOURCES  
BUREAU OF LAND & WATER RESOURCES

MAY 19 1980

RECEIVED

If well telescopes please sketch and show depths.

GROUND LEVEL

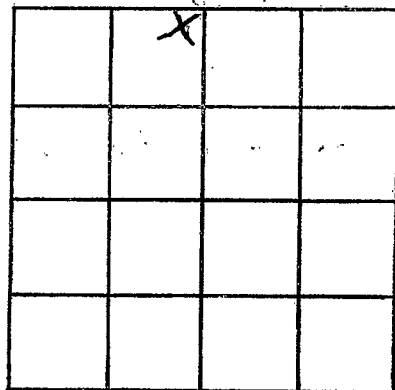

SECTION 17

Please indicate well location X.

ADDITIONAL INFORMATION

If more than one screen, show locations of each on sketch.