

SUNFLOWER

H-66

7/29/80

7-29 1980

MISSISSIPPI BOARD OF WATER COMMISSIONERS
416 North State Street
Jackson, Mississippi 39201

CODED

WATER WELL DRILLERS LOG
BUTANE GAS COMPANY

SUNFLOWER

date well completed

OF GREENWOOD
firm name

county well located

LANDOWNER: SHELTON FARMS

description of formations encountered

from to

Doddsville, Ms

CLAY 1 65
SAND & GRAVEL 65 113

(mailing address)

WELL LOCATION:

sec 19 T 21 N R 4 E
1 miles NW of Doddsville
(distance) (direction) (nearest town)

WELL PURPOSE:

(home, irrigation, municipal, industrial)

CODED

WELL COMPLETION DATA:

- (1) diameter (inches) 16"
- (2) total depth (feet) 113'
- (3) static water level (feet) 22' below top of ground
- (4) casing STEEL 73' (material) (depth)

(size) if telescope see back.

- (5) screen 40' 73' (length) (depth to top)

16" STEEL (size) (material)

- (6) pump 60 2500 (HP) (yield gpm)

DIESEL (type power)

- (7) electric log No (yes or no)

(organization running log)

- (8) how well bottom plugged STEEL PLATE

DRILLERS REMARKS:


DEPT. OF NATURAL RESOURCES
BUREAU OF LAND & WATER RESOURCES

AUG 11 1980

RECEIVED

If well telescopes please sketch and show depths.

GROUND LEVEL

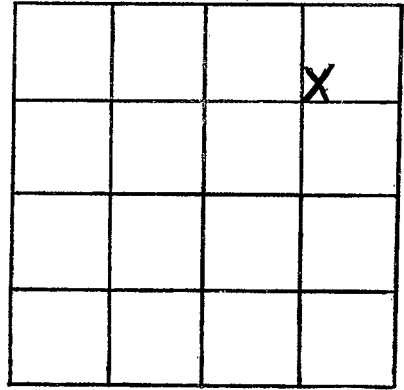

SECTION 19

Please indicate well location X.

ADDITIONAL INFORMATION

If more than one screen, show locations of each on sketch.