

SUNFLOWER
H 68
8-22-80

MISSISSIPPI
 BOARD OF WATER COMMISSIONERS
 416 North State Street
 Jackson, Mississippi 39201

CODED

WATER WELL DRILLERS LOG

August 22 19 80 Bruce Berryman - SUNFLOWER
 date well completed firm name county well located
Greenwood.

LANDOWNER: Mr. Orin Farris	description of formations encountered	from	to
P.O. Box 45,	Clay	0	20
Doddsville. MS	Sand	20	60
(mailing address)	Sand & Gravel	60	180
WELL LOCATION:	Clay	180	200
sec. <u>17</u> T <u>21</u> N R. <u>30</u>	Sand	200	240
<u>3</u> miles <u>SE</u> of <u>RULEVILLE</u>	Clay	240	260
(distance) (direction) (nearest town)	Clay & <u>CODED</u> sand	260	300
WELL PURPOSE: Home	Clay	300	320
(home, irrigation, municipal, industrial)	Sand	320	400
WELL COMPLETION DATA:	Clay	400	540
(1) diameter (inches) <u>4" x 2"</u>	Fine sand	540	560
(2) total depth (feet) <u>601'</u>	Sand	560	600
(3) static water level (feet) <u>26</u> below top of ground.	Clay	600	630
(4) casing <u>4" Blk.</u> - <u>126'</u>			
(material) <u>2" galv.</u> (depth) <u>455'</u>			
<u> </u> If telescope see back.			
(size)			
(5) screen <u>20'</u> , <u>581'</u>			
(length) (depth to top)			
<u>.010</u> , <u>Stainless steel</u>			
(size) (material)			
(6) pump <u>1 h.p.</u> <u>20</u>			
(HP) (yield gpm)			
<u>Electric</u>			
(type power)			
(7) electric log <u>NO</u>			
(yes or no)			
<u> </u>			
(organization running log)			
(8) how well bottom plugged <u>B.P.V.</u>			

DEPT. OF NATURAL RESOURCES
 BUREAU OF LAND & WATER RESOURCES


SEP 30 1980

RECEIVED

DRILLERS REMARKS:

If well telescopes please sketch and show depths.

GROUND LEVEL

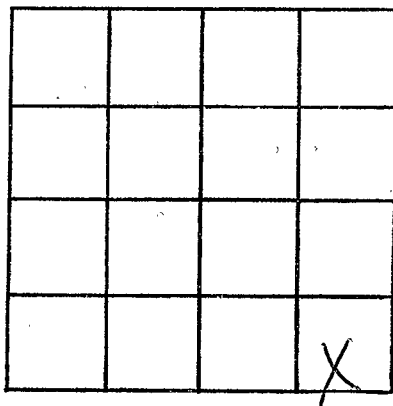

SECTION 17

Please indicate well location X.

ADDITIONAL INFORMATION

If more than one screen,
show locations of each on sketch.