

MISSISSIPPI DEPARTMENT OF NATURAL RESOURCES

Bureau of Land and Water Resources

Southport Mall

P.O. Box 10631

Jackson, Mississippi 39209

WATER WELL DRILLERS LOG

CODED

SUNFLOWER
H 69
8-18-80

GW 5775
SW/NW, Sec. 21
Elev. 126

8/18 1980 DYER WELL FIRR SUNFLOWER
date well completed firm name county well located

LANDOWNER:
PENTE COST FARMS
P.O. BOX 51
DODDSVILLE, MISS 38736
(mailing address)

description of formations encountered	from to	
	ft	ft
CLAY	0	30
FINE SAND	30	38
SAND	38	50
SAND & GRAVEL	50	113

WELL LOCATION:
sec. 21 T. 21 N. R. 3 E
S. W.
1/2 miles N of DODDSVILLE
(distance) (direction) (nearest town)

WELL PURPOSE:
(home, irrigation, municipal, industrial)

WELL COMPLETION DATA:

(1) diameter (inches) 16

(2) total depth (feet) 113

(3) static water level (feet) 18 below top of ground.

(4) casing STEEL, 73 (material) (depth)
16 (size) if telescope see back.

(5) screen 40, 73 (length) (depth to top)
16, STEEL (size) (material)

(6) pump 60, 3000 (HP) (yield gpm)
ELECTRIC (type power)

(7) electric log NO (yes or no)
(organization running log)

(8) how well bottom plugged STEEL PLATE

CODED

DEPT. OF NATURAL RESOURCES
BUREAU OF LAND & WATER RESOURCES


OCT - 1 1980

RECEIVED

DRILLERS REMARKS:

If well telescopes please sketch and show depths.

GROUND LEVEL

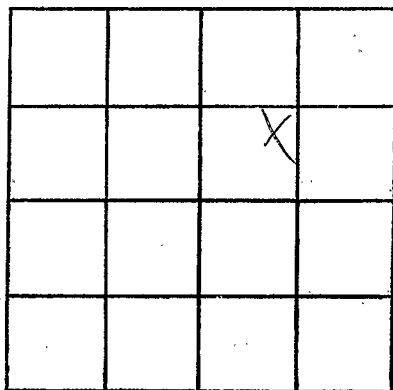

SECTION 21

Please indicate well location X.

ADDITIONAL INFORMATION

If more than one screen, show locations of each on sketch.