

MISSISSIPPI DEPARTMENT OF NATURAL RESOURCES

Bureau of Land and Water Resources

Southport Mall

P.O. Box 10631

Jackson, Mississippi 39209

WATER WELL DRILLERS LOG

CODED

Sunflower

H-72

4-23-81

4-23-81 19

Dyer Wells Dring

Sunflower

date well completed

firm name

county well located

LANDOWNER: Butei Farm Service

description of formations encountered	depth	
	from	to
<u>Clay</u>	<u>13</u>	<u>23</u>
<u>Clay</u>	<u>23</u>	<u>33</u>
<u>sand</u>	<u>33</u>	<u>43</u>
<u>sand</u>	<u>43</u>	<u>53</u>
<u>sand & gravel</u>	<u>53</u>	<u>63</u>
<u>sand & gravel</u>	<u>63</u>	<u>73</u>
<u>gravel</u>	<u>73</u>	<u>83</u>
<u>gravel</u>	<u>83</u>	<u>93</u>
<u>gravel</u>	<u>93</u>	<u>103</u>
<u>gravel</u>	<u>103</u>	<u>113</u>

(Chake Lindsay)

Daddsville, MS.

(mailing address)

WELL LOCATION:

sec 35 T 21 N R 3 E
4 miles EAST of Daddsville
 (distance) (direction) (nearest town)


WELL PURPOSE:

(home, irrigation, municipal, industrial)


WELL COMPLETION DATA:

- (1) diameter (inches) 16"
- (2) total depth (feet) 113'
- (3) static water level (feet) 20' below top of ground.
- (4) casing Steel 113'
 (material) (depth)
- 16" If telescope see back.
 (size)
- (5) screen 40' 73'
 (length) (depth to top)
- 16" Steel
 (size) (material)
- (6) pump 60 3000
 (HP) (yield gpm)
- Diesel
 (type power)
- (7) electric log (yes or no)
- (organization running log)
- (8) how well bottom plugged plate

CODED

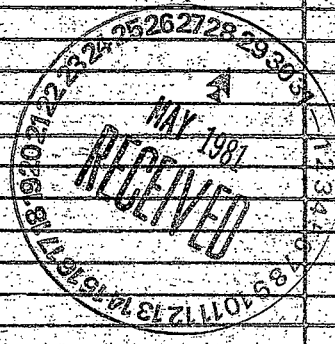

DRILLERS REMARKS:

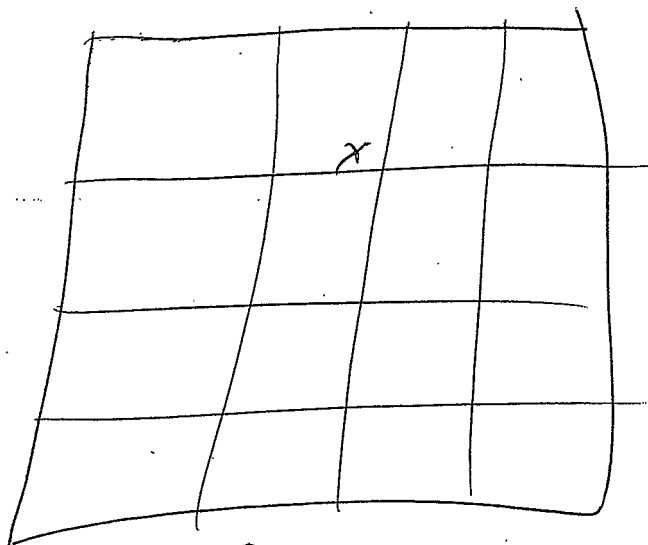

Sec 35