

MISSISSIPPI DEPARTMENT OF NATURAL RESOURCES

Bureau of Land and Water Resources

Southport Mall

P.O. Box 10631

Jackson, Mississippi 39209

WATER WELL DRILLERS LOG

0096
CODED

Sunflower

H 74

2-26-81

GW 5777

NW/SE, Sec. 20

Elev. 125

19 81

Dyer

Sum.

date well completed

firm name

county well located

LANDOWNER:

NORMAN PENTECOST

Doddsville, MS

(mailing address)

description of formations encountered

from

to

Clay	0	28
Fine Sand	28	40
Sand	40	62
Sand & Gravel	62	113

WELL LOCATION:

sec. 20 T-21 N R-3 E

1 miles N of Doddsville
(distance) (direction) (nearest town)

CODED

WELL PURPOSE:

(home, irrigation, municipal, industrial)


WELL COMPLETION DATA:

- (1) diameter (inches) 16
- (2) total depth (feet) 113
- (3) static water level (feet) 21 below above top of ground.
- (4) casing Steel 113'
(material) (depth)
- 16" If telescopic see back.
(size)
- (5) screen 40' 73'
(length) (depth to top)
- 16" Steel
(size) (material)
- (6) pump 40 2000
(HP) (yield gpm)
- electric
(type power)

(7) electric log (yes or no)

(organization running log)

(8) how well bottom plugged plate

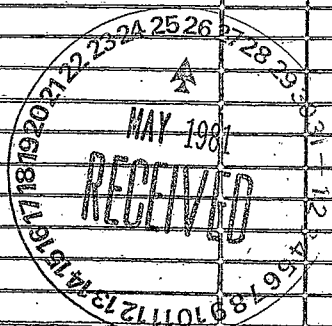

DRILLERS REMARKS:

A hand-drawn 4x4 grid with an 'X' in the second row, third column.

		X	

Sec 20.