

Bureau of Land and Water Resources

Southport Mall

P.O. Box 10631

Jackson, Mississippi 39209

WATER WELL DRILLERS LOG

105
CODED

Sunflower
H-75
2-27-81

2/27 1981
date well completed

Dyer
firm name

Sum.
county well located

LANDOWNER:
L.D. McCoy
Doddsville, MS.
(mailing address)

description of formations encountered	depth	
	from	to
<u>Clay</u>	<u>0</u>	<u>28</u>
<u>fine sand</u>	<u>28</u>	<u>38</u>
<u>Sand</u>	<u>38</u>	<u>54</u>
<u>Sand & Gravel</u>	<u>54</u>	<u>107</u>
<u>Rock</u>		

WELL LOCATION:
Sec. 21 T. 21 N. R. 3 E
S W
1 miles NE of Doddsville
(distance) (direction) (nearest town)

WELL PURPOSE:
(home, irrigation, municipal, industrial)

CODED

WELL COMPLETION DATA:

(1) diameter (inches) 16"

(2) total depth (feet) 107'

(3) static water level (feet) 21' below above top of ground.

(4) casing Steel 107'
(material) (depth)

16" If telescopic see back.
(size)

(5) screen 40' 67'
(length) (depth to top)


16" steel
(size) (material)

(6) pump 60 3000
(HP) (yield gpm)

diesel
(type power)

(7) electric log (yes or no) _____
(organization running log) _____

(8) how well bottom plugged plate

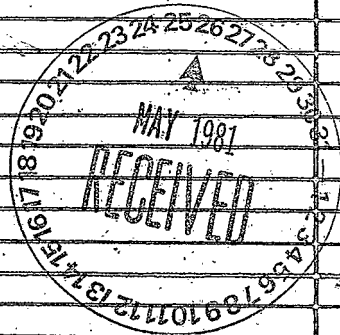

DRILLERS REMARKS:

Sec 21

A hand-drawn grid consisting of 4 columns and 3 rows. A horizontal line is drawn across the second row from the top. In the top-right cell of the grid, there is a small, faint mark that appears to be the number '4'.

			4