

Sunflower
H 76
3-31-80

MISSISSIPPI
BOARD OF WATER COMMISSIONERS
416 North State Street
Jackson, Mississippi 39201

CODED

WATER WELL DRILLERS LOG

3/31 19 80 Dyer Sun
date/well completed firm name county well located

LANDOWNER:
JOHNNIE NICHOLS
DODDSVILLE, MS.
(mailing address)

description of formations encountered	from	to
Clay	0	38'
Fine sand	38	60
Sand	60	65
Sand & Gravel	65	109

WELL LOCATION:
sec. 35 T 21 N R 3 E
3 miles SE of Doddsville
(distance) (direction) (nearest town)

WELL PURPOSE:
(home, irrigation, municipal, industrial)

WELL COMPLETION DATA:

(1) diameter (inches) 16"

(2) total depth (feet) 109'

(3) static water level (feet) 22' below top of ground.

(4) casing Steel 109'
(material) (depth)
16" if telescope see back.
(size)

(5) screen 40' 69'
(length) (depth to top)
16" Steel
(size) (material)


(6) pump 60 3000
(HP) (yield gpm)
Diesel
(type power)

(7) electric log (yes or no)

(organization running log)

(8) how well bottom plugged plate


CODED

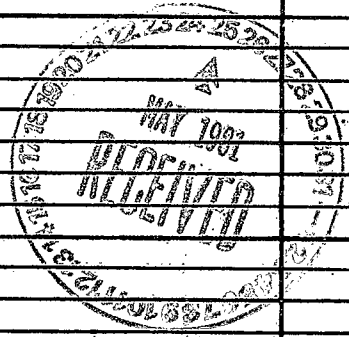

DRILLERS REMARKS:

If well telescopes please sketch and show depths.

GROUND LEVEL

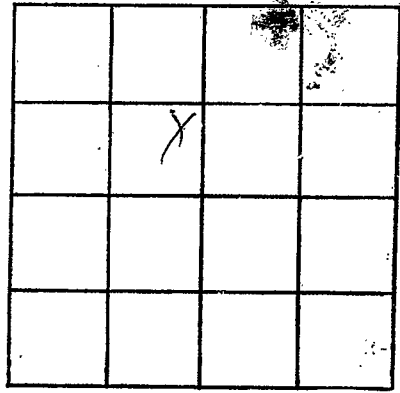

SECTION 35

Please indicate well location X.

ADDITIONAL INFORMATION

A series of horizontal lines for writing additional information.

If more than one screen, show locations of each on sketch.