

MISSISSIPPI DEPARTMENT OF NATURAL RESOURCES

Bureau of Land and Water Resources

Southport Mall

P.O. Box 10631

CODED

Jackson, Mississippi 39209

WATER WELL DRILLERS LOG

SUNFLOWER
H 77
6-15-81

6/15/81
date well completed

19 Dyerwell + Wrigler
firm name

Sunflower
county well located

LANDOWNER: Wm Spring St

description of formations encountered

from

to

Cleveland, Tutwiler, Ms.
(mailing address)

<u>Clay</u>	<u>0</u>	<u>18</u>
<u>Thin Sand</u>	<u>18</u>	<u>38</u>
<u>Sand</u>	<u>38</u>	<u>50</u>
<u>Sand + Gravel</u>	<u>50</u>	<u>106</u>

WELL LOCATION:

sec. 3 T 21 N R 3 E
3 miles SE of ROSEVILLE
(distance) (direction) (nearest town)

WELL PURPOSE:

(home, irrigation, municipal, industrial)

CODED

WELL COMPLETION DATA:

- (1) diameter (inches) 16
- (2) total depth (feet) 106
- (3) static water level (feet) 23 below top of ground.
- (4) casing Steel (material), (depth) 16 (size) if telescope see back.
- (5) screen 40' (length), (depth to top) 16 (size), (material)
- (6) pump (HP) 3000 (yield gpm) Diesel (type power)
- (7) electric log (yes or no)
- (organization running log)
- (8) how well bottom plugged Plate

DEPT. OF NATURAL RESOURCES
BUREAU OF LAND & WATER RESOURCES


JUN 18 1981

RECEIVED

DRILLERS REMARKS:

If well telescopes please sketch and show depths.

GROUND LEVEL

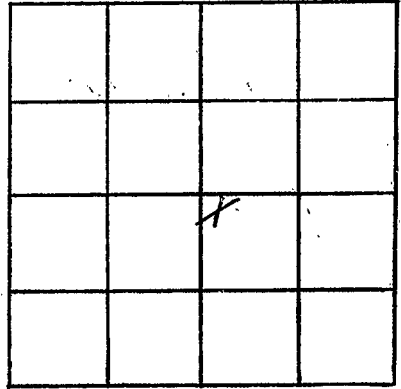

SECTION 3

Please indicate well location X.

ADDITIONAL INFORMATION

If more than one screen, show locations of each on sketch.