

SUNFLOWER

H 79

5-14-80

MISSISSIPPI BOARD OF WATER COMMISSIONERS
416 North State Street
Jackson, Mississippi 39201

CODED

WATER WELL DRILLERS LOG

5/14 1980
date well completed

Dyer
firm name

Sum.
county well located

LANDOWNER:

JOHNNIE NICHOLS

DODDSVILLE, MS.
(mailing address)

description of formations encountered

from

to

Clay

0

28

Fine sand

28

38

Sand

38

48

Sand + Gravel

48

106

WELL LOCATION:

sec. 26 T 12 N R 3 E
3 miles E of Doddsville
(distance) (direction) (nearest town)

WELL PURPOSE:


(home, irrigation, municipal, industrial)

WELL COMPLETION DATA:

- (1) diameter (inches) 16"
- (2) total depth (feet) 106'
- (3) static water level (feet) 21' below top of ground.
- (4) casing 16" 106'
(material) (depth)
16" if telescope see back.
(size)
- (5) screen 40' 66'
(length) (depth to top)
16" Steel
(size) (material)
- (6) pump 60 3000
(HP) (yield gpm)
Diesel
(type power)
- (7) electric log
(yes or no)

(organization running log)
- (8) how well bottom plugged plate


CODED

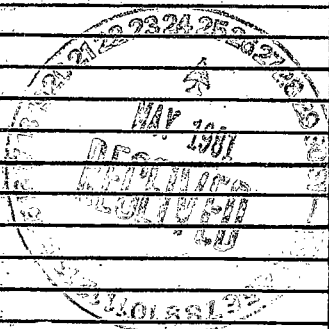

DRILLERS REMARKS:

If well telescopes please sketch and show depths.

GROUND LEVEL

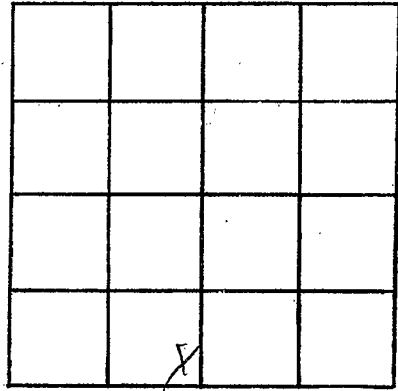

SECTION 26

Please indicate well location X.

ADDITIONAL INFORMATION

If more than one screen,
show locations of each on sketch.