

SUNFLOWER  
H 80  
2-28-80

MISSISSIPPI  
BOARD OF WATER COMMISSIONERS  
416 North State Street  
Jackson, Mississippi 39201

GW 10278  
SE/SW, Sec. 32

Elev. 125.


CODED

WATER WELL DRILLERS LOG

2/28 1980 Dyer Sun.  
date well completed firm name county well located


LANDOWNER:	description of formations encountered	from	to
JOHN NICHOLS			
DREW, MISS. (mailing address)	Clay	0	28
	Fine sand	28	38
	Sand	38	43
	Sand & Gravel	43	103
WELL LOCATION:			
sec. 32 T. 21 N. R. 3 E. W. 1 1.21 miles S of Pochmulle			
WELL PURPOSE: (home, irrigation, municipal, industrial)			
WELL COMPLETION DATA:			
(1) diameter (inches) 12			
(2) total depth (feet) 103'			
(3) static water level (feet) 21' below top of ground.			
(4) casing Steel 103' (material) (depth)			
12" if telescope see back. (size)			
(5) screen 40' 63' (length) (depth to top)			
12" Steel (size) (material)			
(6) pump 40 2000 (HP) (yield gpm)			
propane (type power)			
(7) electric log (yes or no)			
(organization running log)			
(8) how well bottom plugged plate			
DRILLERS REMARKS:			

CODED

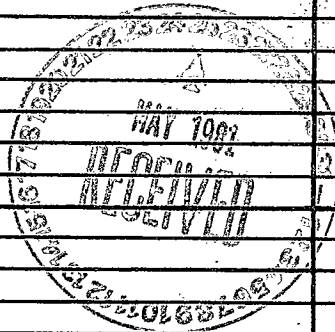

If well telescopes please sketch and show depths.

GROUND LEVEL

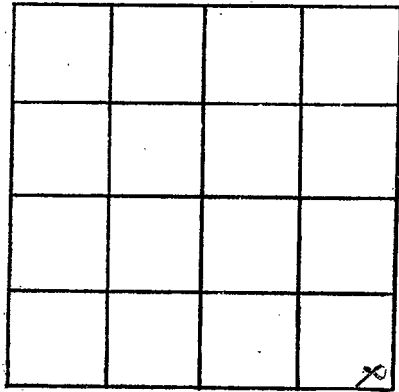

SECTION 32

Please indicate well location X.

ADDITIONAL INFORMATION

If more than one screen,  
show locations of each on sketch.