

MISSISSIPPI DEPARTMENT OF NATURAL RESOURCES

Bureau of Land and Water Resources

Southport Mall

P.O. Box 10631

CODED

Jackson, Mississippi 39209

WATER WELL DRILLERS LOG

Sunflower  
H 81  
6-30-81

date well completed

firm name

county well located

Dyer Well + Dring Sew

Sunflower

LANDOWNER:

Lade Lindsey  
389 Ruby Drive  
Rulville, Ms  
 (mailing address)

description of formations encountered

from

to

WELL LOCATION:

sec. 2 T 21 N R. 3 E  
 S W  
4 miles SE of R. Walle  
 (distance) (direction) (nearest town)

WELL PURPOSE:


(home, irrigation, municipal, industrial)

WELL COMPLETION DATA:

- (1) diameter (inches) 16
- (2) total depth (feet) \_\_\_\_\_
- (3) static water level (feet) 21 below above top of ground.
- (4) casing Steel (material) \_\_\_\_\_ (depth) \_\_\_\_\_  
16 (size) if telescope see back.
- (5) screen 40 (length) \_\_\_\_\_ (depth to top) \_\_\_\_\_  
16 (size) \_\_\_\_\_ (material)
- (6) pump 12 (HP) 2000 (yield gpm)  
Electric (type power)
- (7) electric log NO (yes or no)
- \_\_\_\_\_ (organization running log)
- (8) how well bottom plugged Plate


DRILLERS REMARKS:

<u>sand</u>	<u>13</u>	<u>23</u>
<u>sand clay</u>	<u>23</u>	<u>33</u>
<u>sand</u>	<u>33</u>	<u>43</u>
<u>sand &amp; gravel</u>	<u>43</u>	<u>53</u>
<u>gravel</u>	<u>53</u>	<u>63</u>
<u>gravel</u>	<u>63</u>	<u>73</u>
<u>hard gravel</u>	<u>73</u>	<u>83</u>
<u>gravel</u>	<u>83</u>	<u>93</u>
<u>gravel</u>	<u>93</u>	<u>103</u>
<u>an a fact</u>	<u>103</u>	<u>108</u>

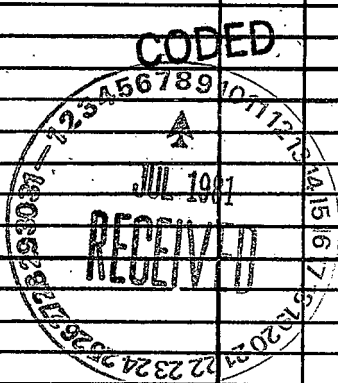

If well telescopes please sketch and show depths.

GROUND LEVEL

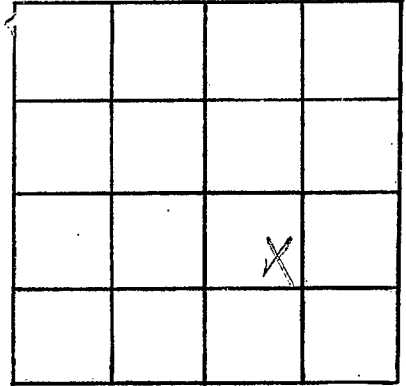

SECTION \_\_\_\_\_

Please indicate well location X.

ADDITIONAL INFORMATION

If more than one screen,  
show locations of each on sketch.