

MISSISSIPPI DEPARTMENT OF NATURAL RESOURCES

Bureau of Land and Water Resources

Southport Mall

P.O. Box 10631

Jackson, Mississippi 39209

WATER WELL DRILLERS LOG

CODED

SUNFLOWER
H 82
7-17-81

July 17, 1981 date well completed
Larry's well & pump firm name
Sunflower county well located

LANDOWNER: Walker Powell

description of formations encountered

from to

Dalville
(mailing address)

CLAY	0	40
FINE & MEDIUM SAND	40	50
COARSE SAND	50	150

WELL LOCATION

sec. 27 T 12 N R 3 E
3 miles (distance) E (direction) of Dalville (nearest town)

WELL PURPOSE:

(home, irrigation, municipal, industrial)

WELL COMPLETION DATA:

- (1) diameter (inches) 8"
- (2) total depth (feet) 100'
- (3) static water level (feet) 26' below top of ground.
- (4) casing Plastic, 60' (material) (depth)
- (size) if telescope see back.
- (5) screen 40' (length), 60' (depth to top)
- 8" (size), Plastic (material)
- (6) pump 10 (HP), 700 (yield gpm)
- (type power)
- (7) electric log NO (yes or no)
- (organization running log)
- (8) how well bottom plugged PVC cap

CODED


DRILLERS REMARKS:

DEPT. OF NATURAL RESOURCES
BUREAU OF LAND & WATER RESOURCES

OCT 19 1981
RECEIVED

If well telescopes please sketch and show depths.

GROUND LEVEL

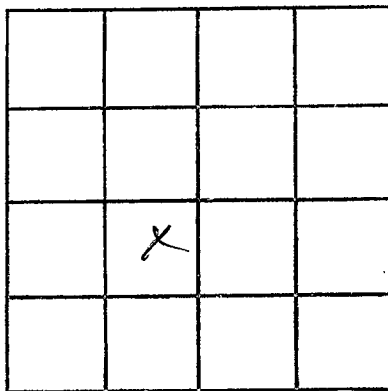

SECTION 27

Please indicate well location X.

ADDITIONAL INFORMATION

If more than one screen,
show locations of each on sketch.