

**SUNFLOWER**  
**H 85**  
**7/81**

MISSISSIPPI  
 BOARD OF WATER COMMISSIONERS Elev. 125  
 416 North State Street  
 Jackson, Mississippi 39201  
**CODED**

GW 5307  
 SE/SE, Sec. 15

**WATER WELL DRILLERS LOG**

July 21, 1981 date well completed Cook Drilling Co. firm name Sunflower county well located

LANDOWNER:	description of formations encountered	from	to
<u>Travis Richardson</u>			
<u>12 seed mine</u> (mailing address)	<u>Shale</u>	<u>742</u>	<u>12'</u>
	<u>Sand &amp; gravel</u>	<u>77</u>	<u>40'</u>
	<u>Sand</u>	<u>40</u>	<u>65'</u>
	<u>Sand &amp; gravel</u>	<u>65</u>	<u>110'</u>
<b>WELL LOCATION:</b>			
<u>15</u> sec. <u>21</u> T. <u>21</u> N. R. <u>3</u> E. <u>W</u>			
<u>6</u> miles <u>SE</u> of <u>Rehoboth</u>			
(distance) (direction) (nearest town)			
<b>WELL PURPOSE:</b> (home, irrigation, municipal, industrial)			
<b>WELL COMPLETION DATA:</b>			
(1) diameter (inches) <u>8 1/2"</u>			
(2) total depth (feet) <u>110'</u>			
(3) static water level (feet) <u>28</u> below top of ground.			
(4) casing <u>PVC</u> <u>70'</u> (material) (depth)			
<u>8"</u> (size) if telescope see back.			
(5) screen <u>40'</u> <u>70'</u> (length) (depth to top)			
<u>8"</u> <u>PVC</u> (size) (material)			
(6) pump <u>10</u> <u>600</u> (HP) (yield gpm)			
<u>3/4</u> (type power)			
(7) electric log <u>no</u> (yes or no)			
(organization running log)			
(8) how well bottom plugged			
<b>DRILLERS REMARKS:</b>			

**CODED**


DEPT. OF NATURAL RESOURCES  
 BUREAU OF OIL & GAS RESOURCES

NOV 6 1981

**RECEIVED**

If well telescopes please sketch and show depths.

GROUND LEVEL

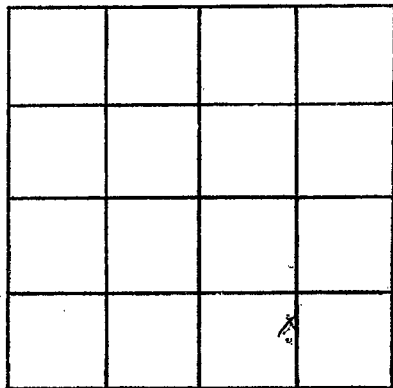

SECTION 24

Please indicate well location X.

ADDITIONAL INFORMATION

If more than one screen,  
show locations of each on sketch.