

SUNFLOWER  
H 86  
71/81

MISSISSIPPI  
 BOARD OF WATER COMMISSIONERS  
 416 North State Street  
 Jackson, Mississippi 39201

CODED

WATER WELL DRILLERS LOG

July 31 1981 Cook Drilling Co - Sunflower  
 date well completed firm name county/well located

LANDOWNER:  
Travis Richardson  
Drew Mason  
 (mailing address)

description of formations encountered	from	to
<u>Plm</u>	<u>780</u>	<u>154</u>
<u>5' soft s-sand</u>	<u>18'</u>	<u>60'</u>
<u>2' soft l-gravel</u>	<u>60'</u>	<u>110'</u>

WELL LOCATION:  
 sec 15 T 21 N R 3 E  
3 1/2 miles S.E. of Rehville  
 (distance) (direction) (nearest town)

WELL PURPOSE:  
 (home, irrigation, municipal, industrial)

- WELL COMPLETION DATA:
- diameter (inches) 8"
  - total depth (feet) 110'
  - static water level (feet) 28' below top of ground
  - casing 100' 70'  
 (material) (depth)  
8" If telescope see back.  
 (size)
  - screen 80' 70'  
 (length) (depth to top)  
8" PVC  
 (size) (material)
  - pump 10 600  
 (HP) (yield gpm)  
Clear  
 (type power)
  - electric log \_\_\_\_\_  
 (yes or no)
- (organization running log)
- (8) how well bottom plugged Cap

DEPT. OF NATURAL RESOURCES  
 BUREAU OF LAND & WATER RESOURCES


NOV 6 - 1981

RECEIVED

DRILLERS REMARKS:

If well telescopes please sketch and show depths.

GROUND LEVEL

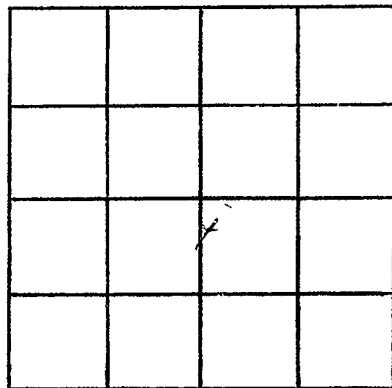

SECTION 15

Please indicate well location X.

ADDITIONAL INFORMATION

If more than one screen,  
show locations of each on sketch.