

SUNFLOWER
H 87
71 181
GW 5310

MISSISSIPPI
 BOARD OF WATER COMMISSIONERS
 416 North State Street
 Jackson, Mississippi 39201 **CODED**

WATER WELL DRILLERS LOG

July 21, 19 Loop Drilling Co. Sunflower
 date well completed firm name county/well located

LANDOWNER:
Travis Richardson
10 new man
 (mailing address)

description of formations encountered	from	to
<u>Clay</u>	<u>Top</u>	<u>18'</u>
<u>Sand and</u>	<u>18'</u>	<u>60'</u>
<u>Sand & gravel</u>	<u>60'</u>	<u>123'</u>

WELL LOCATION:
 sec 11 T 21 N R J E
8 3/4 miles S.E. of Rehoboth
 (distance) (direction) (nearest town)

WELL PURPOSE:
 (home, irrigation, municipal, industrial)

- WELL COMPLETION DATA:
- diameter (inches) 16"
 - total depth (feet) 123'
 - static water level (feet) 28' below top of ground.
 - casing Steel 83'
 (material) (depth)
16" if telescope see back.
 (size)
 - screen 40' 83'
 (length) (depth to top)
16" Steel
 (size) (material)
 - pump 40 1400
 (HP) (yield gpm)
Power unit
 (type power)
 - electric log NO
 (yes or no)
- (organization running log)
- (8) how well bottom plugged


CODED

DEPT. OF NATURAL RESOURCES
 BUREAU OF LAND & WATER RESOURCES
 NOV 6 - 1991
RECEIVED

DRILLERS REMARKS:

If well telescopes please sketch and show depths.

GROUND LEVEL

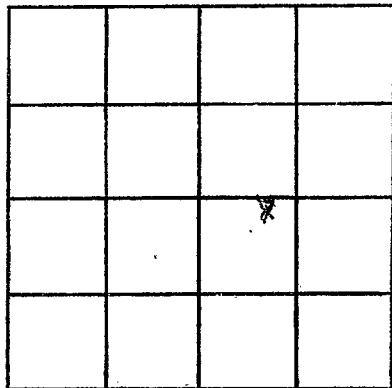

SECTION 15

Please indicate well location X.

ADDITIONAL INFORMATION

If more than one screen, show locations of each on sketch.